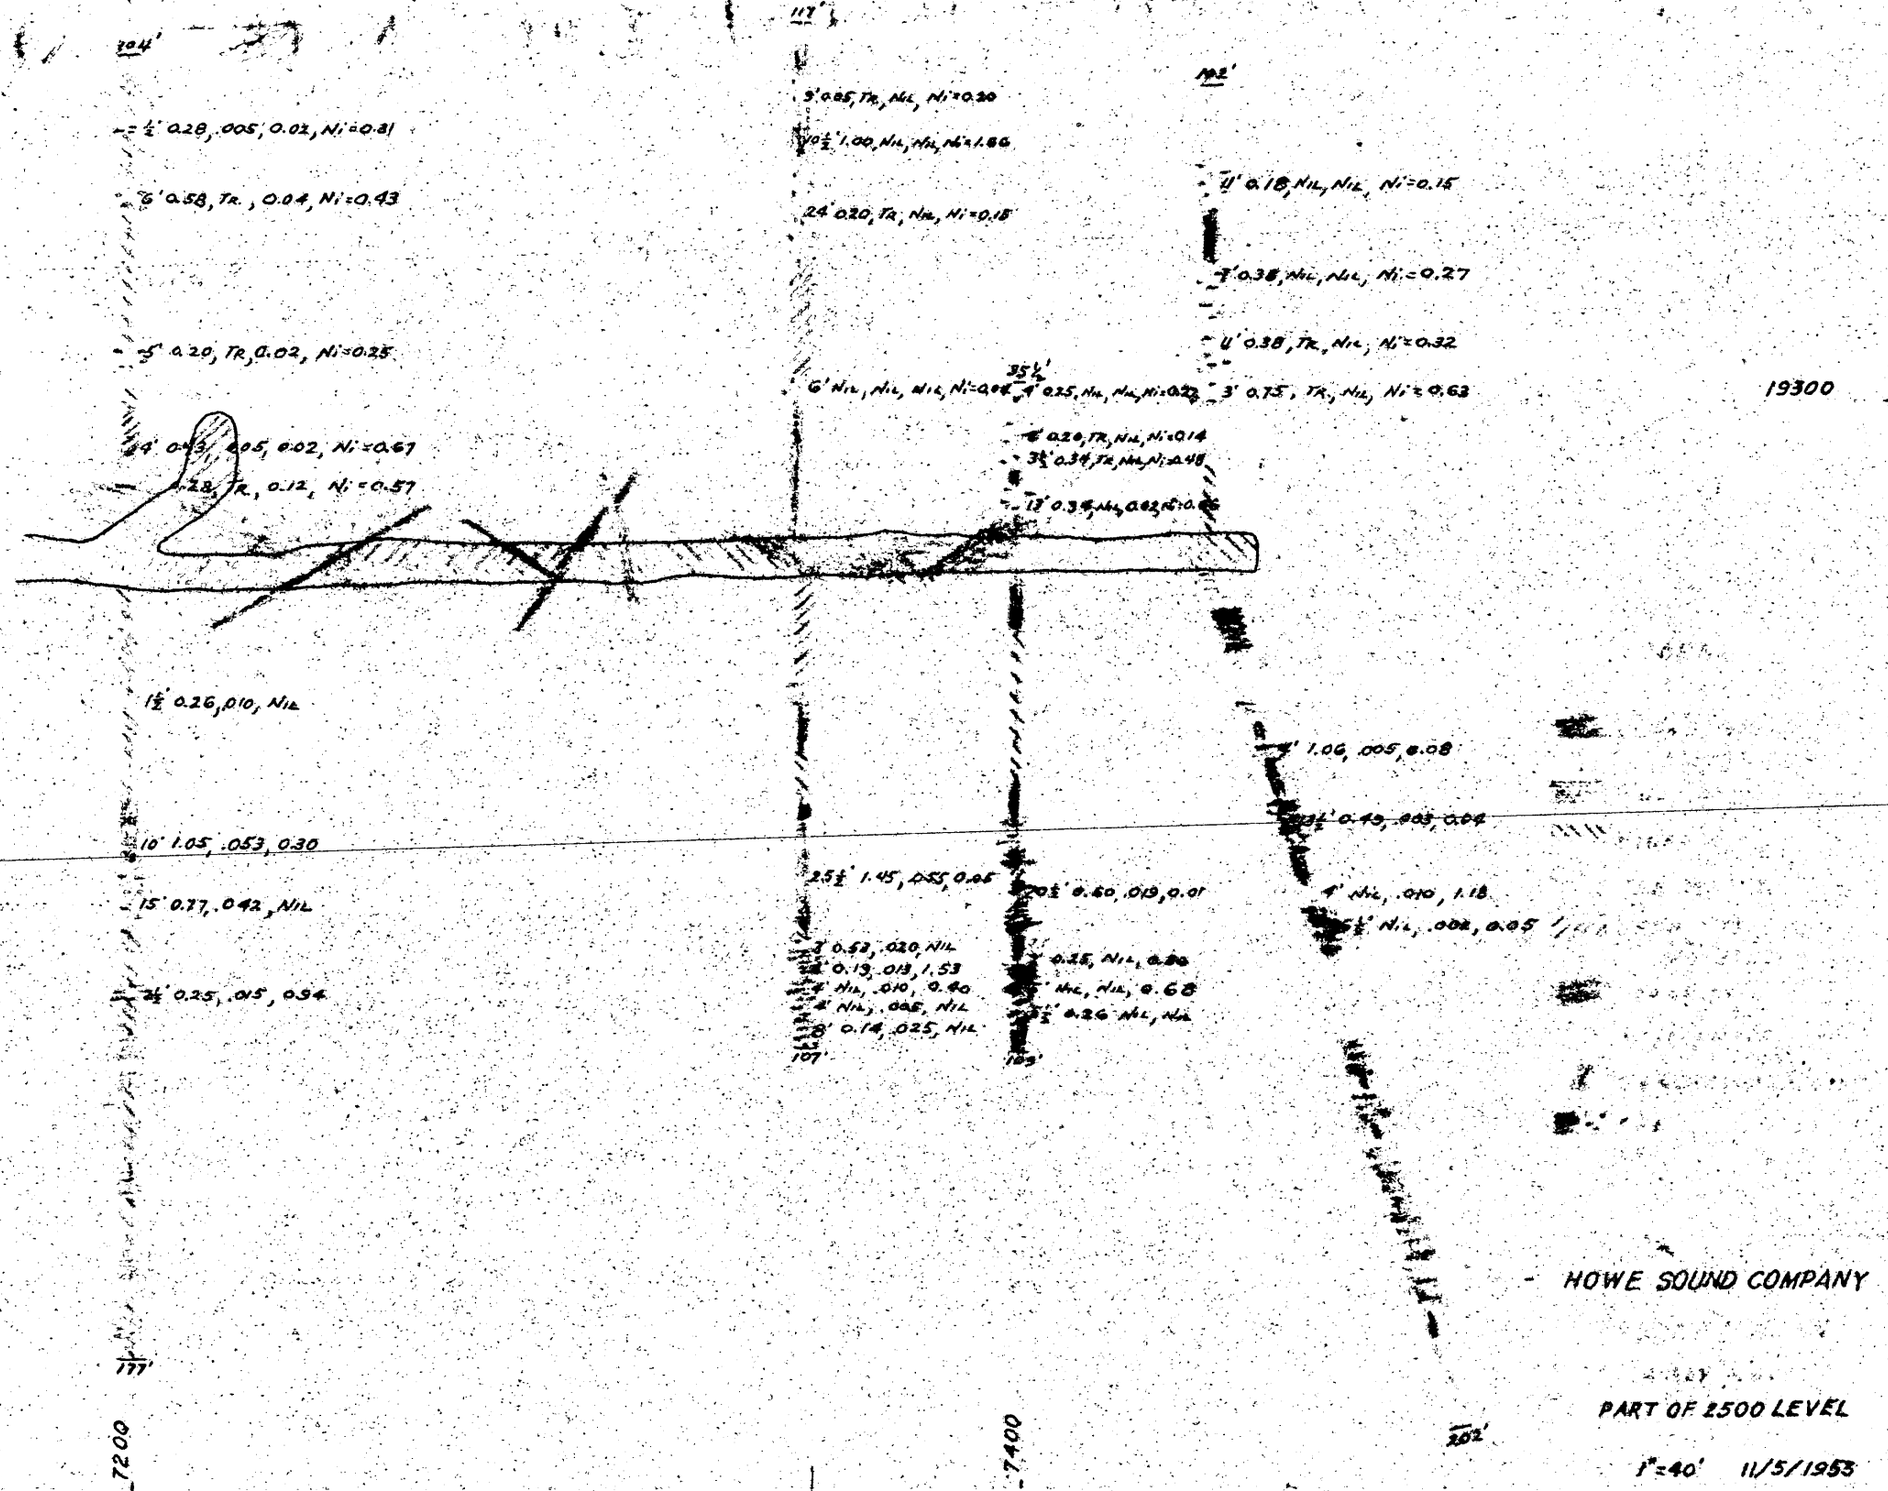
104'
117'
102'
19300
= ½' 0.28, .005, 0.02, Ni=0.31
6' 0.58, Tr., 0.04, Ni=0.43
5' 0.20, Tr, 0.02, Ni=0.25
4' 0.43, .005, 0.02, Ni=0.67
28, Tr., 0.12, Ni=0.57
1½' 0.26, .010, Nil
10' 1.05, .053, 0.30
15' 0.77, .042, Nil
2½' 0.25, .015, 0.94
3' 0.85, Tr, Nil, Ni=0.20
10½' 1.00, Nil, Nil, Ni=1.66
24' 0.20, Tr, Nil, Ni=0.18
6' Nil, Nil, Nil, Ni=0.04
35½'
4' 0.25, Nil, Nil, Ni=0.22
6' 0.20, Tr, Nil, Ni=0.14
3½' 0.34, Tr, Nil, Ni=0.48
13' 0.34, Nil, 0.02, Ni=0.46
25½' 1.45, .055, 0.05
3' 0.52, .020, Nil
4' 0.13, .013, 1.53
4' Nil, .010, 0.40
2' Nil, .005, Nil
8' 0.14, .025, Nil
107'
109'
0.60, .019, 0.01
0.25, Nil, 0.80
Nil, Nil, 0.68
½' 0.26 Nil, Nil
11' 0.18, Nil, Nil, Ni=0.15
7' 0.38, Nil, Nil, Ni=0.27
11' 0.38, Tr, Nil, Ni=0.32
3' 0.75, Tr, Nil, Ni=0.63
4' 1.06, .005, 0.08
½' 0.49, .003, 0.04
4' Nil, .010, 1.18
½' Nil, .002, 0.05
HOWE SOUND COMPANY
177'
202'
7200
7400
PART OF 2500 LEVEL
1"=40' 11/5/1953

Maps accompanying Operator's letter 4/3/56

Hold for additional info - from Field - Per phone call to Weisenborn 8/26

Mr. Waskey: 10-8-51

Mr. Bryson called and left this message:

DMA 1922X - Field report, last page, shows Township ~~Mx~~. 9-North.

Mr. Bryson just had word from Hugh Waesche that this should be 17 North

NAME OR TITLE OF PERSON, DEPARTMENT, ADDRESS, AND ROOM

RUN STOP

Use other side first

U. S. GOVERNMENT PRINTING OFFICE : 1951 16—38949a-2

U. S. Government Messenger Envelope

Standard Form No. 65 (Rev. 1/46)

1. Use blocks consecutively, one at a time.
2. Void previous block.
3. Write clearly.

NAME OR TITLE OF PERSON, DEPARTMENT, ADDRESS, AND ROOM		NAME OR TITLE OF PERSON, DEPARTMENT, ADDRESS, AND ROOM	
~~Mr R. H. Gordon~~ ~~Petroleum Administration for Defense~~	RUN / STOP	Anna Farr Room 6254	RUN / STOP
Mr H. H. Wilson Room 2056	RUN / STOP		RUN / STOP
Mr Stratton #6071	RUN / STOP		RUN / STOP
	RUN / STOP		RUN / STOP
Refining Div	RUN / STOP	~~Mr Scott Alt Room 4444~~	RUN / STOP
	RUN / STOP	Mr. Pennington Rm. 3653	RUN / STOP
~~Room 6527~~	RUN / STOP	W. R. Geiswold Rm 4444	RUN / STOP
~~Production Div. Colonial Village~~	RUN / STOP		RUN / STOP
~~Transmission~~	RUN / STOP		RUN / STOP
MRS. STRATTON - PAD FILES	RUN / STOP		RUN / STOP

Send surplus envelopes to supply room for reissue.

Use other side

16—38949a-2

Use RUN and STOP only when messenger service between Government buildings in Washington is required.
Your mail room has RUN and STOP information.

U. S. Government Messenger Envelope

Standard Form No. 65 (Rev. 1/46)

1. Use blocks consecutively, one at a time.
2. Void previous block.
3. Write clearly.

NAME OR TITLE OF PERSON, DEPARTMENT, ADDRESS, AND ROOM		NAME OR TITLE OF PERSON, DEPARTMENT, ADDRESS, AND ROOM	
~~L. Haught~~ ~~Room 3026~~	RUN STOP		RUN STOP
Director, Technical Review Staff.	RUN STOP		RUN STOP
~~Joseph C. McCracken~~ ~~Rm 6649~~	RUN STOP		RUN STOP
Mr W. Chamberlain Room 4454	RUN STOP		RUN STOP
Operator's Trial Rept May - 7-3-57	RUN STOP		RUN STOP
	RUN STOP		RUN STOP
	RUN STOP		RUN STOP
	RUN STOP		RUN STOP
	RUN STOP		RUN STOP

Send surplus envelopes to supply room for reissue.

Use other side

Use RUN and STOP only when messenger service between Government buildings in Washington is required. Your mail room has RUN and STOP information.

10