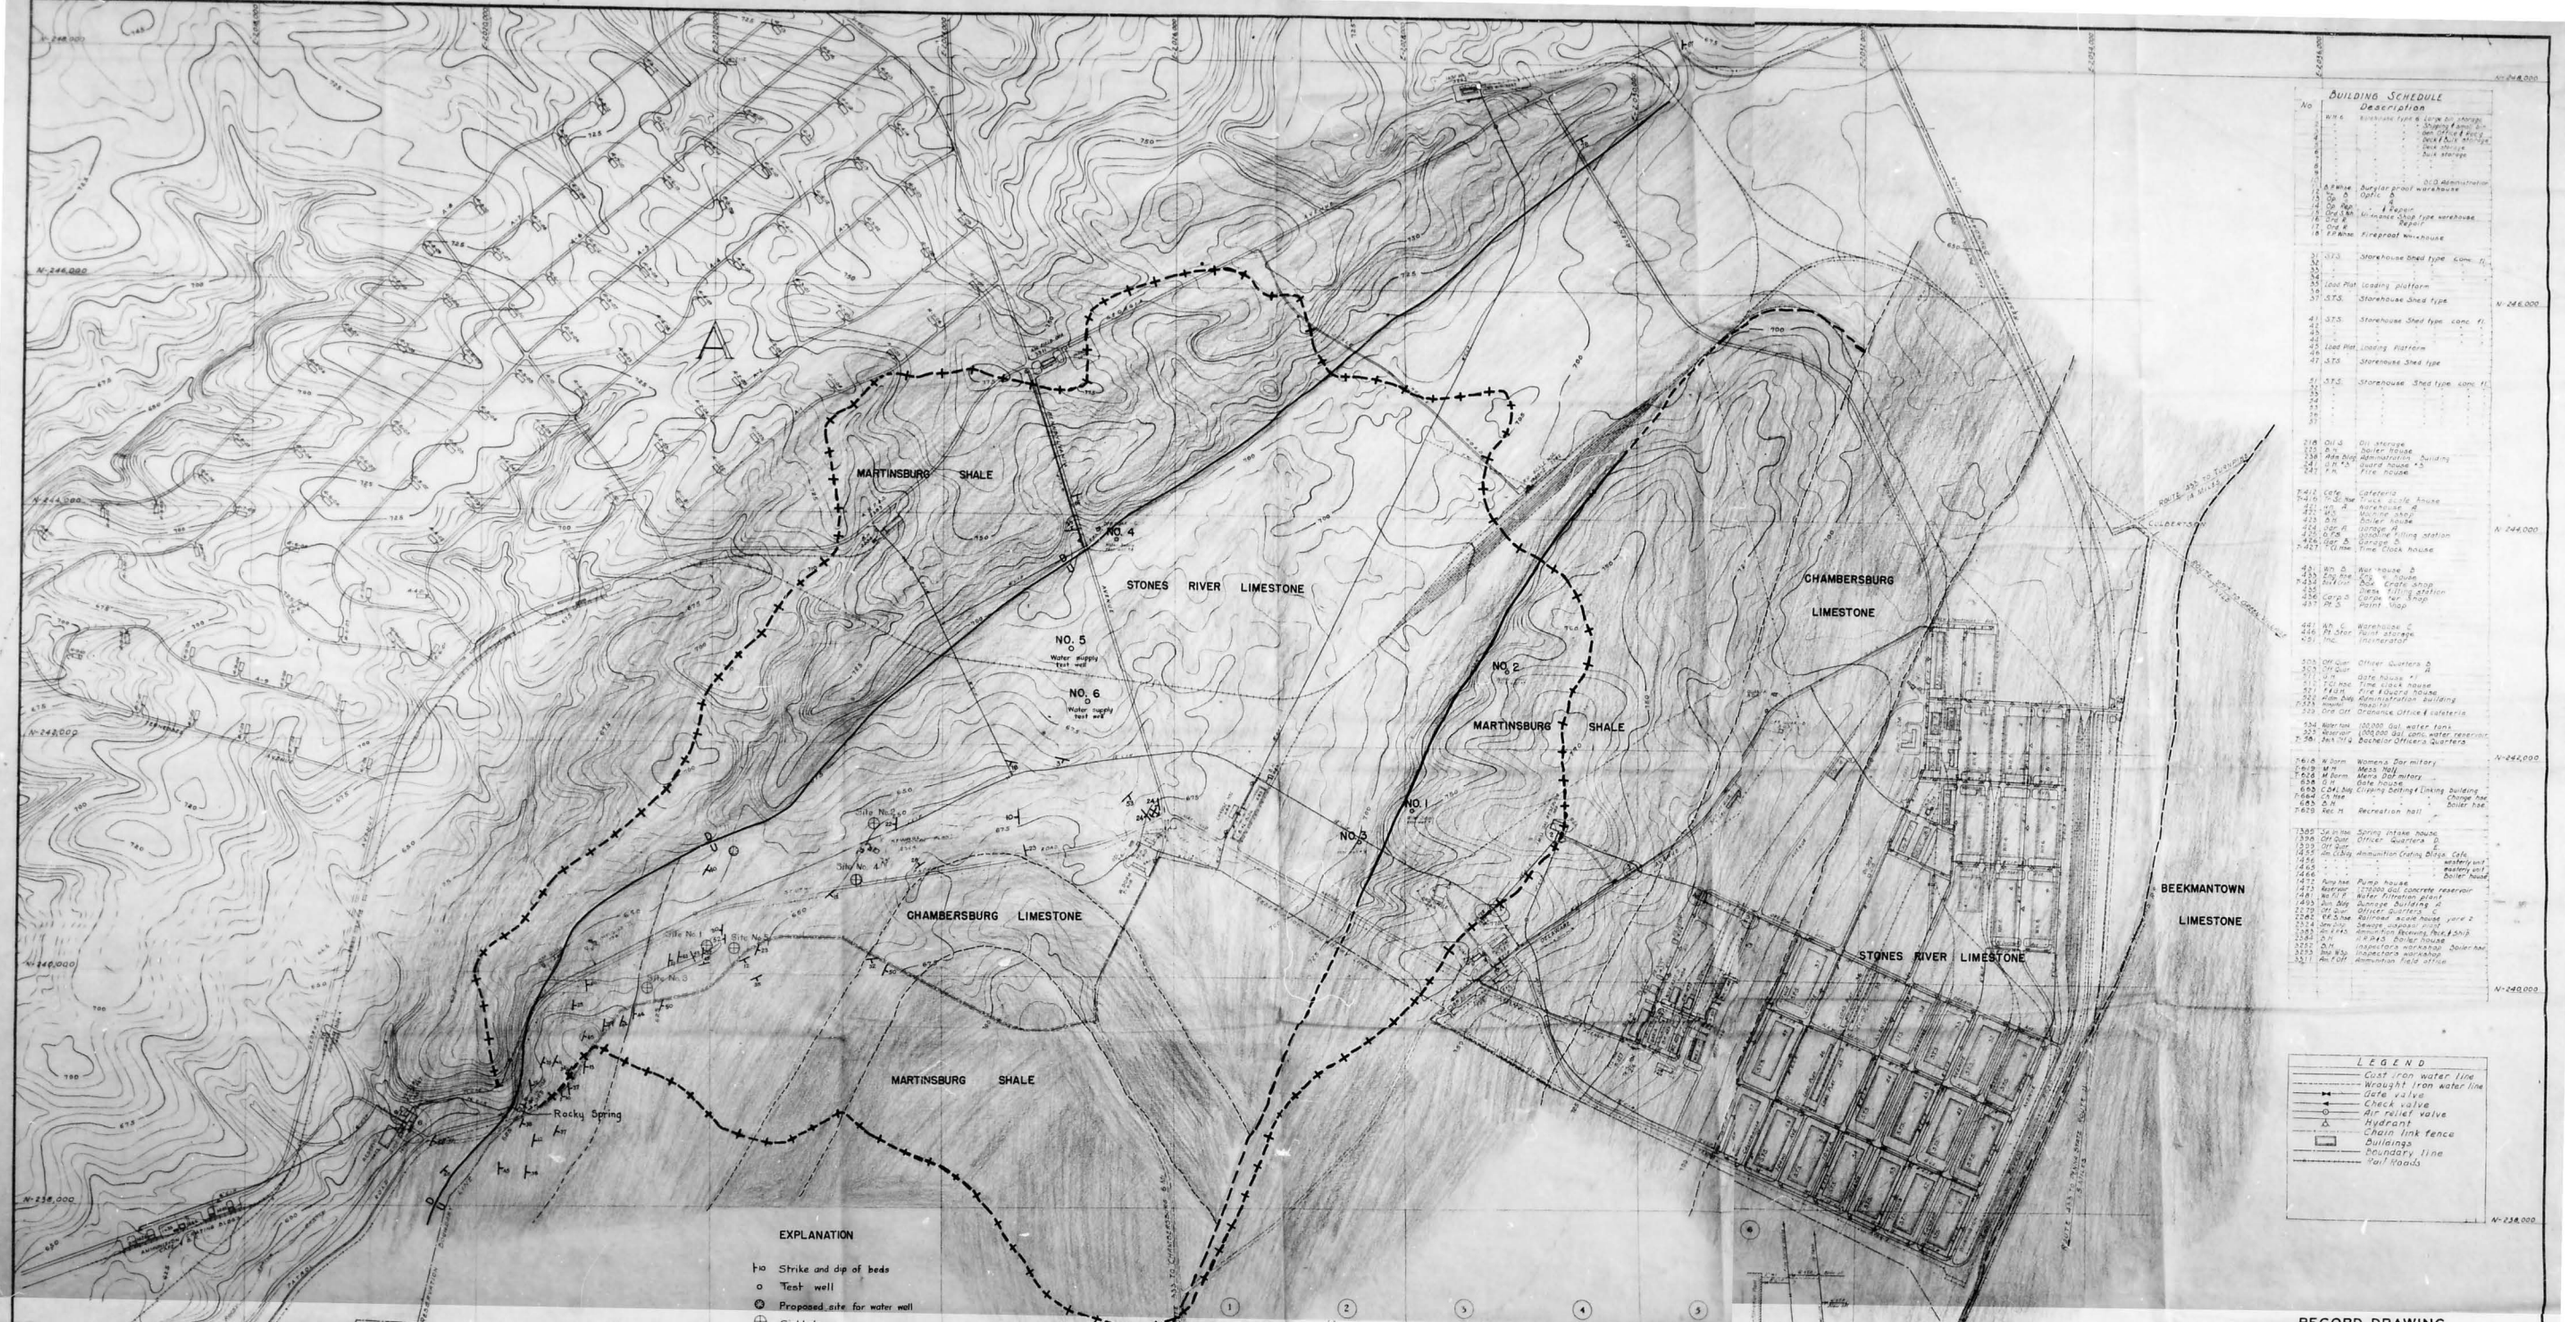
MARTINSBURG SHALE
STONES RIVER LIMESTONE
CHAMBERSBURG LIMESTONE
BEEKMANTOWN LIMESTONE
NO. 1
NO. 2
NO. 3
NO. 4
NO. 5
Water supply test well
NO. 6
Water supply test well
Site No. 2
Site No. 4
Site No. 1
Site No. 3
Rocky Spring
EXPLANATION
Strike and dip of beds
Test well
Proposed site for water well
Sinkhole
Quarry
Approximate outline of catchment area
Geologic boundary
Inferred geologic boundary
Fault
Inferred fault
BUILDING SCHEDULE
Description
LEGEND
Cast iron water line
Wrought iron water line
Gate valve
Check valve
Air relief valve
Hydrant
Chain link fence
Buildings
Boundary line
Rail Roads
RECORD DRAWING
LETTERKENNY ORDNANCE DEPOT
CHAMBERSBURG, PENNSYLVANIA
WATER DISTRIBUTION SYSTEM
SCALE 1 IN. = 400 FT.
IN 1 SHEETS
SHEET NO. 1
U. S. ENGINEER OFFICE, BALTIMORE, MD.
DATE JUNE 3 1943
SUBMITTED:
APPROVAL RECOMMENDED:
APPROVED:
PRINCIPAL ENGINEER CHIEF, ENGINEERING DIVISION
CORPS OF ENGINEERS CHIEF, ENGINEERING DIVISION
COLONEL, CORPS OF ENGINEERS DISTRICT ENGINEER
LT. COL., CORPS OF ENGINEERS AREA ENGINEER
DESIGNED BY
DRAWN BY
TRACED BY
CHECKED BY
7272-601
GEOLOGIC MAP OF THE SOUTHEAST PART OF LETTERKENNY ORDNANCE DEPOT, SHOWING THE LOCATIONS OF PROPOSED DRILLING SITES
I. LOZIER, INC., ARCHITECT-ENGINEER
LETTERKENNY ORDNANCE DEPOT, CHAMBERSBURG, PA.
DATE
REVISION
REV.
CHK.
APPR.