


(200)  
✓  
UNITED STATES,  
DEPARTMENT OF THE INTERIOR  
GEOLOGICAL SURVEY.

*Report on the geology of the highway construction*  
**ENGINEERING GEOLOGY AS APPLIED TO  
HIGHWAY CONSTRUCTION**

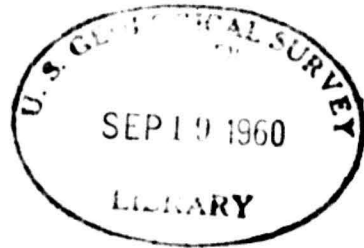

by

• Leonard M Gard, Jr.

This report is preliminary and has not been edited or reviewed for conformity with Geological Survey standards or nomenclature.

## CONTENTS

	Page
Abstract . . . . .	1
Part I. Background for engineering geology . . . .	3
Geology as applied to highway construction	4
Part II. Engineering Geology of the relocation align- ment of State Highway 93 near Marshall, Colo. . . . .	7
Purpose of the investigation . . . . .	7
Location . . . . .	8
Previous geologic work . . . . .	8
Acknowledgements . . . . .	9
Geology . . . . .	9
Stratigraphy . . . . .	9
Pierre shale . . . . .	9
Fox Hills sandstone . . . . .	10



	Page
<b>Stratigraphy (Continued)</b>	
Laramie formation . . . . .	10
Pediment gravel . . . . .	12
Structure . . . . .	13
Engineering significance of the geology . . . . .	14
Methods of investigation . . . . .	14
Geologic formations . . . . .	17
Pierre shale . . . . .	17
Fox Hills sandstone . . . . .	17
Laramie formation . . . . .	18
Pediment gravel . . . . .	20
Ground water conditions . . . . .	21
Landslides . . . . .	23
Recommendations . . . . .	24
Station 10 <del>4</del> 50 and 17 <del>4</del> 50 . . . . .	24
Station 23 to 28 . . . . .	25
Station 35 to 49 . . . . .	26
Station 49 to 52 <del>4</del> 12 . . . . .	26
Station 52 <del>4</del> 12 and 53 . . . . .	26
Station 61 to 67 . . . . .	27
Station <del>75</del> 75 to 81 <del>4</del> 50 . . . . .	27
Station 89 to 96 . . . . .	28
Station 100 to 107 . . . . .	29

## Recommendations (Continued)

Station 120 to 125 . . . . .	30
Station 138 to 144 . . . . .	30
Station 166 to 173 . . . . .	30
Station 178 to 186 . . . . .	31
Station 201 to 205 . . . . .	31
Part III Conclusions . . . . .	32
Bibliography . . . . .	34

## Illustrations

	Page
<b>Plate 1. Geologic map of Marshall-Rocky Flats road</b>	
relocation. . . . .	9a
<b>2. A. Looking back (North) from station 24. Before</b>	
excavation of proposed cut at station 16.	
<b>B. After excavation of same cut. Gravel capped</b>	
Pleistocene terrace on Fox Hills sandstone. . . . .	17a
<b>3. Fault at station 65. . . . .</b>	19a
<b>4. A. Looking back (north) from station 75 toward</b>	
proposed cut from station 61 to 67.	
<b>B. After excavation of same cut. . . . .</b>	21a
<b>5. A. Looking ahead (south) from station 82 toward</b>	
proposed cut at station 90.	
<b>B. After excavation of same cut. . . . .</b>	22a
<b>6. Isometric block diagram of road cut from stations</b>	
89 to 92. . . . .	22b
<b>7. A. Looking back (north) from station 180 before</b>	
excavation of cuts from station 166 to 183.	
<b>B. After excavation of same cuts. . . . .</b>	23a
<b>8. Explanation of plates 10 through 63 . . . . .</b>	In pocket
<b>9. Location of Plates 10 through 21 on highway alignment.</b>	In pocket

<b>Plates 10 through 21. Plan and profile of highway alignment</b>	
with geology added . . . . .	In pocket
<b>Plates 22 through 63. Cross sections of highway alignment</b>	
with geology added . . . . .	In pocket
<b>Figure 1. Location diagram of Marshall-Rocky Flats road</b>	
relocation . . . . .	7a
<b>2. Composite lithologic section of Laramie formation</b>	
measured along right of way . . . . .	20a
	20b

# **ENGINEERING GEOLOGY AS APPLIED TO HIGHWAY CONSTRUCTION**

---

by  
**Leonard M. Gard, Jr.**

---

## **ABSTRACT**

A geologic study of the site for a relocated segment of State Highway 93 northwest of Denver, Colo., was made by the Engineering Geology Branch of the U. S. Geological Survey as a demonstration of the applicability of geologic mapping to problems of highway construction. The relocated segment provides access to the Rocky Flats plant of the Atomic Energy Commission.

The geologic conditions along five miles of the relocation route were examined. In most places apparently well-indurated sandstones of the Upper Cretaceous Fox Hills sandstone and Laramie formation can be excavated without using explosives. The intersection of a six foot thick coal seam in the roadbed in one proposed cut was predicted and removal and replacement with more suitable subgrade material was recommended. Near Marshall the alignment crosses three northeast-trending normal faults which do not adversely affect the highway.

Clay minerals with expanding properties are present in some of the claystones of the Laramie, and special measures must be taken to ensure that ground water will not seep into them and cause swelling beneath the roadbed. Late Tertiary or Early Quaternary gravels cap pediments along the mountain front. Ground water issuing from seeps and springs found at the contact between these gravels and the underlying bedrock should be intercepted and removed from beneath the roadbed.

**ENGINEERING GEOLOGY AS APPLIED TO HIGHWAY  
CONSTRUCTION  
PART I**

**Background for Engineering Geology**

**"Engineering geology is not a branch of the science of geology; it is the application of all of the branches of the science to the practical problems of Engineering." (Burwell, 1950, p. 2.)**

**As all civil engineering structures are constructed on or in the earth's crust and often are composed of natural materials from the earth's crust it behooves those who design and build these structures to know as much as possible about these materials. The fundamental reasons for using geological information in engineering are to reduce costs and promote safety. Examples of these reasons may be found in many textbooks and papers on Engineering Geology. (Legget, 1939; Paige, 1950; Ries and Watson, 1936.)**

**The increased use that engineers are making of geology in the solution of a great variety of problems involves little essential change in the present techniques of the geologist. Naturally, the more well rounded and experienced the geologist is, the better equipped he is to assist in answering geological problems that arise in engineering practice. Because the fields of geology and engineering are both vast in scope, it is indeed a rare individual who is accomplished in both. It is necessary, however, that both geologists and engineers have sufficient knowledge of the other's field to appreciate their problems and to**

recognize how geology can assist in solving engineering problems.

Geologic reports written for the engineer must be written with clarity and simplicity if they are to be of any value. If the engineer cannot understand a geologic report he will not use it. The geologist who hides behind technical jargon and an aura of profound preoccupation will not be able to convey his ideas to the engineer and, as a result, engineers who come in contact with this type of geologist will lose confidence in geology.

### **Geology Applied to Highway Construction**

Geologic information has been applied in highway construction for many years but only recently has it come into general acceptance by engineers. As early as 1889 a report on highway materials was written (Hill, 1889). Since that time the demand for more and better roads, stemming from the advent and improvement of the motor vehicle, has required more and better knowledge of earth materials. In 1937 two states each employed a geologist in the highway department (Horner and McNeal, 1950, p. 157). In 1951, according to a survey of state highway departments (Horner and Dobrovolsky, 1952) 23 of the 48 state highway departments employed a total of 89 geologists of which Kansas uses 15 and Pennsylvania uses 10. Of the remaining 25 states, many use consulting geologists but do not employ geologists full time. From this it becomes apparent that the application of geological data to highway engineering is rapidly becoming accepted in state highway departments.



Hunting (1945, p. 272) has outlined some of the ways in which a geologist (and therefore geology) can be utilized in highway construction. These are:

- "1. Locating suitable road-surfacing material pits and quarries;
2. Determining the suitability of various earth materials for surfacing, concrete construction, and other highway uses;
3. Sub-grade treatment and classification;
4. Frost heave problems;
5. Predicting the character of material to be excavated;
6. Preventing and correcting landslides;
7. Appraising the competency of materials for bridge foundations;
8. Judging the desirability of bridge sites and road sites with respect to possible changes of stream channels;
9. Investigating proposed tunnel sites;
10. Investigating and predicting sub-surface water conditions and locating underground water supplies;
11. Evaluating mineral lands to be bought or condemned for highway location; and
12. Acting as witness in litigation "

**Descriptions of geological formations merely as sandstone, shale, limestone, granite and the like, are of little value to an engineer. He is mainly interested in the physical properties of a lithologic unit so that he may evaluate it to determine how it will react under certain conditions and what equipment will be needed to excavate it. The engineer divides materials to be excavated into two categories, "rock" and "common." "Rock" to an engineer is any material that is consolidated enough to require the use of explosives to reduce it to a size that can be readily handled by his equipment whereas "common" encompasses those materials that can be handled directly by his equipment.**

**By accurate mapping and the application of sound geological principles to the problems of highway construction, the geologist can aid the highway engineer by predicting materials to be encountered and their properties and can foresee problems that may arise due to geologic conditions.**

**Part II of this paper is an example of a report on the engineering geology of a highway relocation. In order to give the reader a better picture of the geologic setting, it contains more geologic background than is generally included in a report written for engineers.**

## **PART II**

### **Engineering Geology of the Relocation Alignment of State Highway 93 near Marshall, Colo.**

#### **Purpose of the Investigation**

The construction of the Atomic Energy Commission's Rocky Flats plant, northwest of Denver, has led to the improvement of part of State Highway 93 as an access road. In planning for the improvement of the north end of the road, the Colorado Department of Highways decided that a section of the road near the town of Marshall should be relocated to shorten it and to remove some steep grades and sharp curves. This relocation involved making a number of large cuts in bedrock. In the summer of 1953 the Engineering Geology Branch of the U. S. Geological Survey mapped a section of the relocation alignment as a demonstration of the applicability of geologic mapping to problems of highway construction. The purpose of the investigation was twofold; first, to provide geological data in a critical area, and second to demonstrate to the highway department the usefulness of geological data for good low cost highway design and the location of construction materials. The Colorado Department of Highways plans to hire a geologist and this survey would, in part, determine the type of work he will do and enable them to more correctly fit him into their organization. As the request for this work was not made sufficiently far in advance to allow

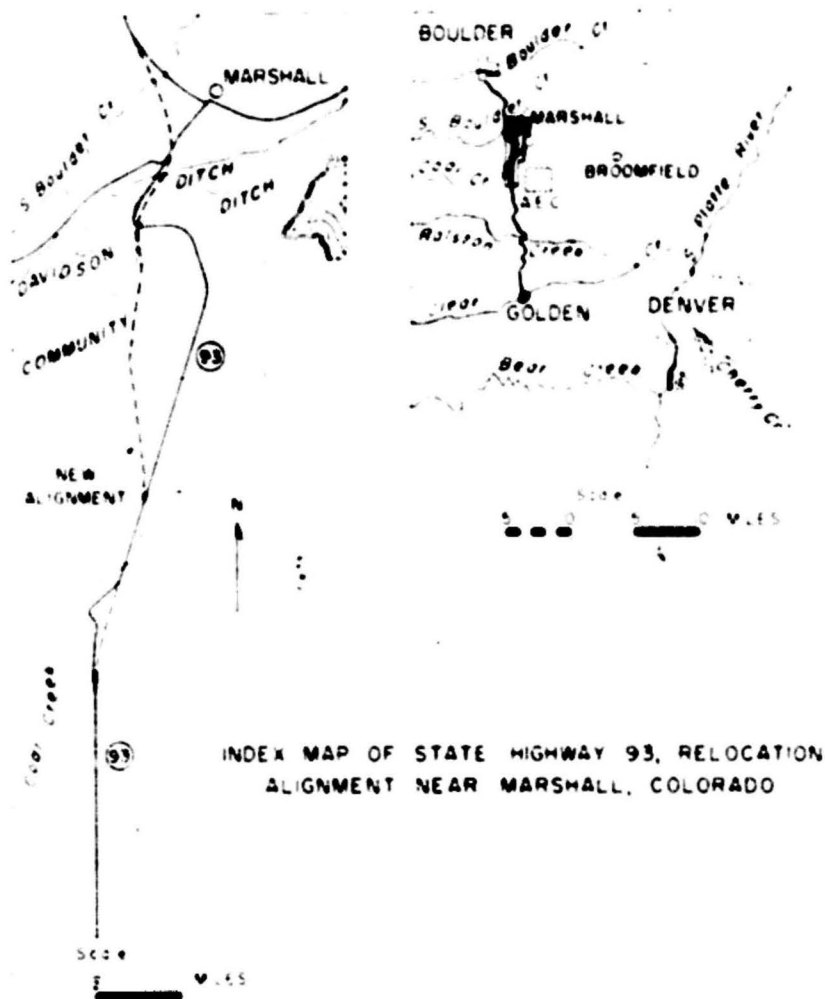


Figure 1

the geologic report to be completed prior to bidding for the contract, the highway department engineers of design, construction, and materials were taken on an inspection trip in the field and some of the more important recommendations were given them orally. Field mapping was done during July and August, 1953, and field checking was done at regular intervals as the construction took place.

### Location

The project is located about 22 miles northwest of Denver and about four miles south of Boulder. It extends south from the town of Marshall to the Rocky Flats Atomic Energy Commission plant, a total length of about 5.2 miles.

### • Previous Geologic work

Early studies in the Denver Basin were made by Emmons, Cross, and Eldridge and the work published in U. S. Geological Survey Monograph 27 (1896). The structure of the Marshall area was mapped in 1935 as a thesis for the University of Colorado (J. F. Johnson, 1935). This previous work served to give a general picture of the geology of the area, but was of little assistance in the detailed mapping. Only a brief description of the general geology and structure will be given here. For more detailed information, the reader is referred to the bibliography at the end of this thesis.

### **Acknowledgements**


This opportunity is taken to acknowledge the guidance and supervision given by Ernest Dobrovolsky of the U. S. Geological Survey and also the assistance and cooperation given by various members of the Colorado State Highway Department, especially for augering many of the test holes and the reproduction of Plates 10 through 63 of this paper.

### **Geology**

The project is located on the west flank of the Denver Basin where sedimentary formations of Pennsylvanian through Paleocene age dip eastward into the Basin. This is on the western border of the Colorado Piedmont, a subdivision of the Great Plains Province. (Fenneman, 1931.) The geologic formations involved in the highway relocation are Pierre shale, Fox Hills sandstone, and Laramie formation, all of Upper Cretaceous age. These formations have been bevelled by several cycles of pedimentation. The bevelled surfaces are capped by late Tertiary or early Quaternary gravel. Later Quaternary terraces along the valleys of South Boulder and Coal Creeks are also capped by gravel.

### **Stratigraphy**

Pierre shale. -- The Pierre shale is a gray-green to black marine shale. It is approximately 10,000 feet thick in this area (Lovering and Goddard, 1950, p. 39); but because it is soft and

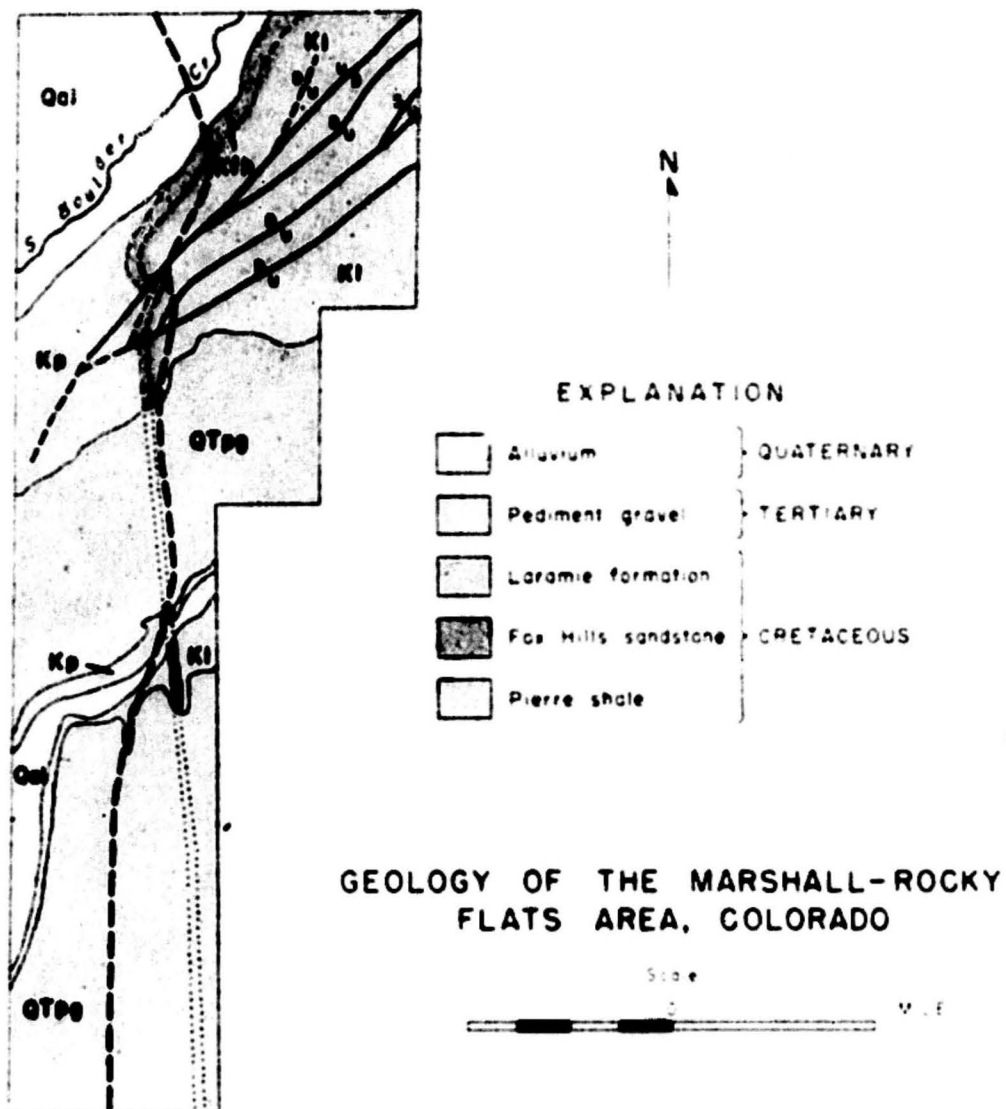

**Plate 1. Geologic map of Marshall-Rocky Flats road relocation.**

easily eroded, it is seldom exposed except in stream banks and man-made cuts. A nearly complete section of the Pierre is exposed in the Denver and Salt Lake Railroad cut seven miles north of Golden. (Moody, 1947.) The Pierre consists mainly of clayey shale with sandy lenses and a few thin bentonite seams. The upper half of the formation is more arenaceous than the lower half. Only the upper 800 feet of the formation was encountered in the highway relocation.

Fox Hills sandstone.-- The Pierre shale grades rapidly into the overlying Fox Hills sandstone which consists of buff to brown friable sandstone, siltstones, and sandy shale. Although the Fox Hills sandstone has been found to be as much as 550 feet thick, (Lavington and Thompson, p. 50, 1948) the maximum thickness measured in the vicinity of Marshall was 130 feet. Lovering and Goddard (op. cit., p. 40) have stated that, "The Fox Hills probably represents a near shore facies of the retreating Upper Cretaceous Sea."

Laramie formation. -- The Laramie formation, overlying the Fox Hills sandstone, is a series of alternating and lensing sandstones, siltstones, claystones, lignitic clays, and coals. This formation is of continental origin and has an average thickness of 600 feet (Lovering and Goddard, 1950, p. 40). Gude (1950, p. 1701) measured a thickness at Golden of 540 feet. This project involves only the lower 132 feet of the Laramie which is repeated by faulting several times along the alignment. Claystones predominate and contain the clay minerals kaolinite, illite, and montmorillonite (Gude, 1950). The sandstones are fine- to



medium-grained and may grade laterally into siltstones in a short distance. The sandstones commonly lense with the claystones and marked changes in thickness are not unusual. The sandstones are friable and porous except locally where they are cemented with iron oxide.

Coal has been mined in the Marshall area since 1863. No mines are presently being operated but one was operated as recently as 1948. The area is dotted with abandoned mines, many of which were abandoned as early as 1881 (Emmons, Cross, and Eldridge, 1896, p. 347). At least one mine had caught fire prior to 1881 (op. cit., p. 348) and coal seams are still burning in at least three places.

There are at least four more or less continuous coal seams here, but only one of them is thick enough to be mined profitably. These coal beds are extremely useful locally for stratigraphic correlation of the Laramie

Correlation between various measured sections of the Laramie formation was found to be impossible because of the rapidly changing lithology. No correlation was made between the Laramie section in the Marshall area and the section measured at Coal Creek for the same reason. A composite section was made from auger hole information along the center line of the highway alignment (Fig. 2). Sometimes when it was not possible to correlate the geology between 100 foot stations on the profile due to the changing lithology, cross sections were made every 50 feet or less. (See Methods of Investigation, p. 15.)

Pediment gravel. -- Several gravel covered, partly dissected pediment surfaces of different levels exist at the edge of the Rocky Mountains in this area. At least three surfaces have been recognized by H. E. Malde, Geologist, U. S. Geological Survey. The highway alignment crosses only one, the Rocky Flats pediment, a bevelled bedrock surface capped by as much as 50 feet of gravel. Worcester (1939, p. 250) has called this feature a "pediment-topped, fan-topped pediment."

The age of both the bedrock cut surface and the gravel is in doubt. It has been implied indirectly (Wahlstrom, 1947) that the Rocky Flats surface could be no older than middle or late Pleistocene. However, according to Van Tuyl and Lovering (1935, p. 1327) the surface is the correlative of their Orodell berm and is late Pliocene in age. They correlate the Orodell berm with Worcester's (1931) upper Pliocene High Mesa Gravel. The surface relief of the pediment gravel is no more than five feet, although the underlying bevelled bedrock has as much as 50 feet of relief. The large amount of relief on the bedrock is due to resistant beds, such as the sandstone in the basal Laramie formation, withstanding pedimentation.

The valleys of South Boulder Creek and Coal Creek contain several gravel-capped terrace levels of Pleistocene age. Late Pleistocene gravel has filled channels in the Rocky Flats gravel. The Pliocene and Pleistocene gravels are similar and have not been con-

sidered separately in this report. Both gravels contain sandy and silty lenses. There is a definite decrease in the grain size of the gravel from the mountain front to the eastern edge of the pediment; however, as the highway alignment traverses the pediment in a north-south direction, the size of material encountered from place to place along the highway is about the same. The material ranges in size from clay-sized particles to boulders ten feet in diameter. Sub-angular to rounded fragments of quartzite, granite, gneiss, schist, and sandstone (usually Fountain and Dakota) are common.

### Structure

The dominating regional structure is the east-dipping foothills monocline, which is broken at a number of places along the foothills by west-dipping, north-trending high angle reverse faults; northwest-trending normal faults, which die out in enechelon folds in the sedimentary rocks to the southeast; and northeast-trending faults, which are both normal and reverse. "The faulted monocline in reality represents the east limb of the great Front Range anticline formed during the Laramide revolution which culminated at the close of Denver time." (Van Tuyl et al, 1938, p. 24-25.) The sedimentary formations involved in this folding are Pennsylvanian through Paleocene (Reichert, p. 47, 1954) in age. Along the Front Range these formations generally dip eastward into the Denver Basin. The Upper Cretaceous formations in the project area generally strike nearly due north and

dip eastward at 45 to 75 degrees, but at the north end of the project, near the town of Marshall, the strike of the Fox Hills, Laramie, and at least upper Pierre swings eastward to N 65° E and the dip decreases to 10° SE. Near Marshall the Fox Hills and Laramie are broken by a complex series of northeast-trending faults that have only 50 to 100 feet of displacement.

Probably at least the upper part of the Pierre is also broken by these faults. However, no evidence was found to support this assumption. Most of the faults in the Marshall area are normal faults with the northwest sides downthrown. Mapping by the Fuels Branch of the U. S. Geological Survey in the Erie, Louisville, and Lafayette coal fields east and northeast of this area has revealed that the northeast-trending faults are far more common than was previously believed. Although most of these are normal faults with the northwest side down-thrown, some are reverse faults and some are hinge faults. Small horsts and grabens also complicate the structural picture.

### Engineering Significance of the Geology

#### Methods of Investigation

Stratigraphic sections were measured and the geology was mapped by plane table. Because a large part of the area is covered by a mantle of soil and gravel, much of the geologic information found on plates 10 to 63 was determined from auger hole information.

For the benefit of the reader who is unfamiliar with the terminology and procedure used in highway surveying, the following description of the methods employed by highway engineers is included. The right of way and centerline of the relocation alignment of State Highway 93 had already been laid out by survey crews prior to the geological investigation. A stake of known elevation and location known as a station was placed every 50 feet along the centerline. These stakes were used in the plane table mapping as reference points and the centerline served as baseline. In laying out a highway centerline, these stations are always measured from one end of the project to the other. The stake 200 feet from the start of the project is known as station 2 + 00 (two plus zero zero). The next stake 250 feet from the start is station 2 + 50 (two plus fifty) and the next 3 + 00 (three plus zero zero) and so forth. Reference to right or left of the centerline is always made when facing in the direction of increasing station numbering and reference to direction along the alignment is referred to as "ahead" or "back."

The geology was mapped by plane table for purposes of constructing a structure contour map. Because of the abrupt changes in the lithology of the Laramie, the lack of good marker horizons, and the paucity of outcrops in many places, structure contouring was abandoned and the stratigraphy was determined along the right of way by test augering and test pitting.

A total footage of more than 728 feet was augered in 111 holes. The Highway Department made available a truck-mounted power auger, but the majority of the holes were augered by hand. The Highway Department provided a plan and profile    / of the highway alignment on a

---

   / A profile of the alignment is a drawing showing a vertical section of the highway alignment cut parallel to the alignment on the center line.

---

horizontal scale of 100 feet to the inch and a vertical scale of 10 feet to the inch. Cross sections made at right angles to the center line were provided at every 100 foot station and at some 50 foot stations at a scale of 5 feet to the inch. The geology was plotted on the cross sections from auger hole information and transferred to the center line profile. Thus with information at least every hundred feet along the center line profile, the geology could be interpolated between these points. By plotting the geology on the alignment profile and cross sections the contractor, resident engineer, and members of the Highway Department were provided with a geological picture superimposed on the plans with which they were familiar and would use during construction (see Plates 10 through 63).

By using information from the cross sections and the center line profile it is possible to construct a three dimensional picture of the geology at any given place along the right of way, thus enabling an accurate prediction to be made of the geologic materials that will be encountered during construction. Plate 6 is an isometric block diagram of the cut between stations 89+00 and 92+00 that was constructed in such a manner.

## Geologic formations

Pierre shale. -- The Pierre shale is encountered in road cuts on both sides of Coal Creek. Prior to construction the Pierre-Fox Hills contact was determined to occur at station 141+45, where it crosses the proposed cut at an angle. This was confirmed when the cut was excavated in February 1954. On the south side of Coal Creek the investigation was assisted by test pits and trenches made by a cement company which was sampling and testing the Pierre shale. The Pierre shale usually is easily removed with power equipment and is classified as "common." No bentonite seams were observed to occur where the Pierre shale was to be exposed in road cuts. On the south side of Coal Creek a situation occurred that indicates some of the hazards of engineering geology. From all available data it appeared that the Pierre shale could readily be excavated with power equipment. The proposed cut was not investigated by augering to its full depth because the available power auger was not capable of drilling to a depth of more than 20 feet. When the cut was excavated, an arenaceous zone in the upper Pierre shale was encountered that required blasting of some 3,000 cubic yards of material (Plate 7). This kind of experience tends to prevent the engineering geologist from becoming complacent and smug.

Fox Hills sandstone. -- The Fox Hills sandstone was encountered at two places in the project, on the north side of Coal Creek, as mentioned above, where it is in contact with the Pierre shale, and in the large cut made between stations ten and sixteen near Marshall (Plate 2). At the latter place a cut was made through a flat-topped ridge

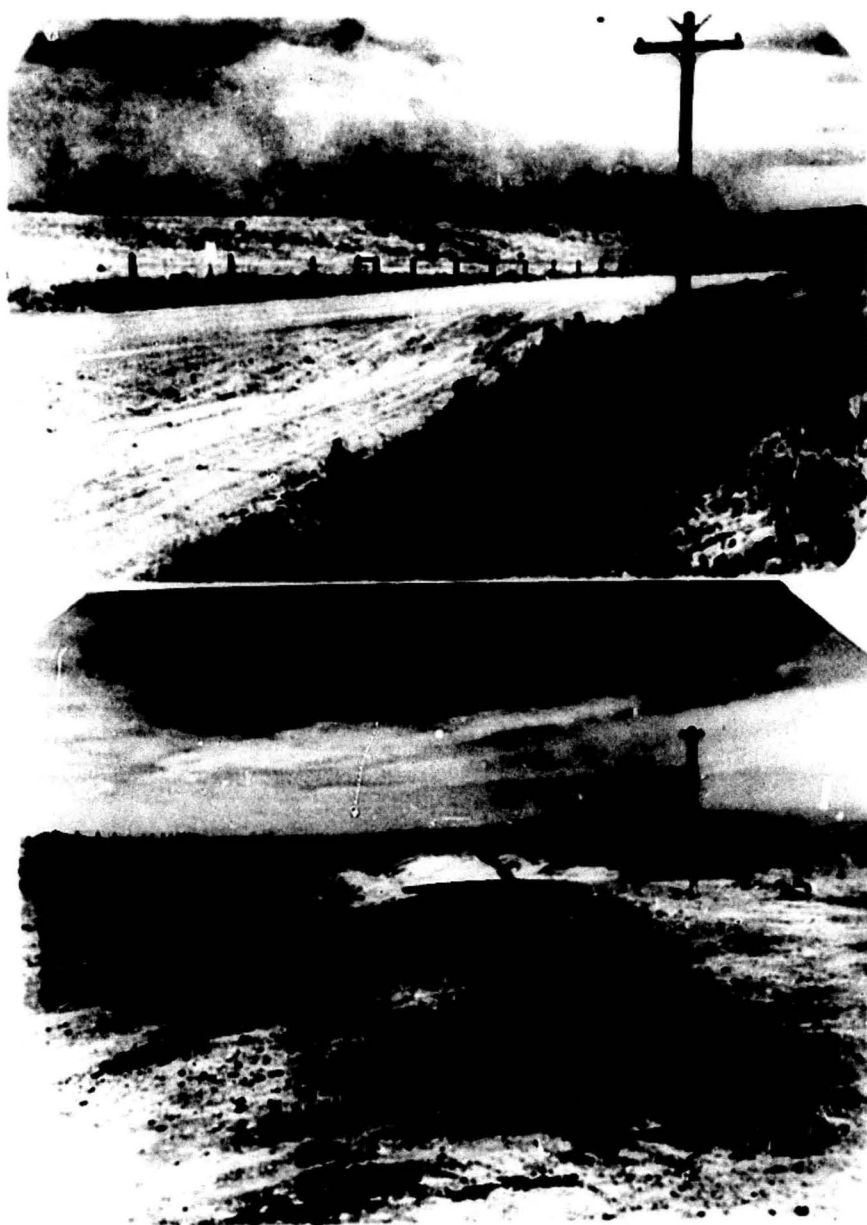


Plate 2. A. Looking back (north) from station 24. Before excavation of proposed cut at station 16.

B. After excavation of same cut. Gravel capped Pleistocene terrace on Fox Hills sandstone. Dark line on cut bank is lignite seam at base of Laramie dipping toward lower right corner of photo.



formed by the Fox Hills sandstone and the basal sandstone of the Laramie formation. This ridge, a Pleistocene terrace of South Boulder Creek, has a bevelled bedrock surface capped by five to eight feet of coarse gravel. Although the Fox Hills gives the appearance of being well indurated, it is friable and poorly cemented and was readily removed by power equipment. The Fox Hills is permeable, but, as it dips away from the road here, water percolating through this formation will not accumulate beneath the road.

Laramie formation. -- The majority of the project involves the Laramie formation. The base of the Laramie, a sandstone bed separated, in this area from the Fox Hills by a seam of lignitic shale, is exposed in the cut at station 15 near Marshall. From this cut to station 33, the road rises in the Laramie section and crosses two thin coal seams at stations 22½/50 and 26½/50. From station 33 to station 52 the road lies on a sandstone member of the Laramie. Either one or both of the underlying thin coal seams have burned, causing minor collapse of the overlying shales and sandstone. The sandstone at the surface is well cemented by iron oxide, but the collapse has fractured it into pieces small enough to allow its removal with power equipment.

At station 52 the Laramie formation is broken by a normal fault striking N 55° E. The northwest side of the fault is downthrown which causes the geologic section to be repeated. In the ditch on the south side of the fault, the upper part of the basal Laramie sandstone again crops out. On this side of the fault, the upper part of this sandstone is

cemented by iron oxide and had to be blasted before removal. Ground water has deposited iron oxide in fractures and pervious bedding planes in some of the Laramie sandstones, which forms extremely hard zones that resist weathering. A good example of this can be seen near station 58.

South from the fault at station 52 the road again rises in the Laramie section and recrosses the two thin coal seams that were found at stations 22/50 and 26/50.

The sandstone member that was so well cemented between stations 33 and 52 is less well cemented where it crops out at station 62 and could be broken loose with a ripper.

The presence of a six foot thick seam of coal in the proposed roadbed at station 64 was determined prior to construction. There was no surface indication of this coal seam. Because of the unstable nature and low bearing strength of coal, it was recommended in the field that the coal be removed and replaced with a more suitable subgrade material.

At station 65 the highway crosses a normal fault that strikes northeast and is down-thrown on the northwest side (Plate 3). This fault has brought the six foot thick coal seam nearly in contact with the same sandstone bed that crops out at the surface between stations 33 and 52 and at station 62. The sandstone is stratigraphically nearly 55 feet below the coal. Local inhabitants indicated that the High View mine, which was on the northwest side of the fault, had been abandoned because the coal had been faulted out. A new mine, the Premier, was




**Plate 3. Fault at station 65. Coal seam at left has been dragged up along fault in center of photo.**

started on the south side of the fault, but also was abandoned when the coal was again offset by a fault that is believed to cross the highway alignment near station 68 (Plate 4). The faults that cross the highway alignment at stations 52, 65, and 68 will not have any adverse effect upon the highway. The fault at station 68 is in a gully and crosses beneath a fill. The faults at stations 52 and 65 cause the same iron oxide cemented sandstone to crop out at three different places along the realignment. The Laramie is present continuously in road cuts from station 15 to station 107 except between stations 91 and 102 where it is buried beneath pediment gravel.


Figure 2 is a composite lithologic section of the Laramie formation measured along the right of way. It soon became apparent that the thicknesses and lithology of all units vary considerably over short distances. The lithologic units commonly are lenticular but no attempt was made to portray this in the column. Thicknesses shown in the column are the ones most closely approximating those shown on the profile.

Pediment gravel. -- The pediment and terrace gravels are classified as "common" excavation. The gravel capping the Rocky Flats pediment contains many badly decomposed fragments, which would prohibit its use as concrete aggregate or road metal. As little concrete was used on this project, the problem of locating a source of concrete aggregate did not arise.

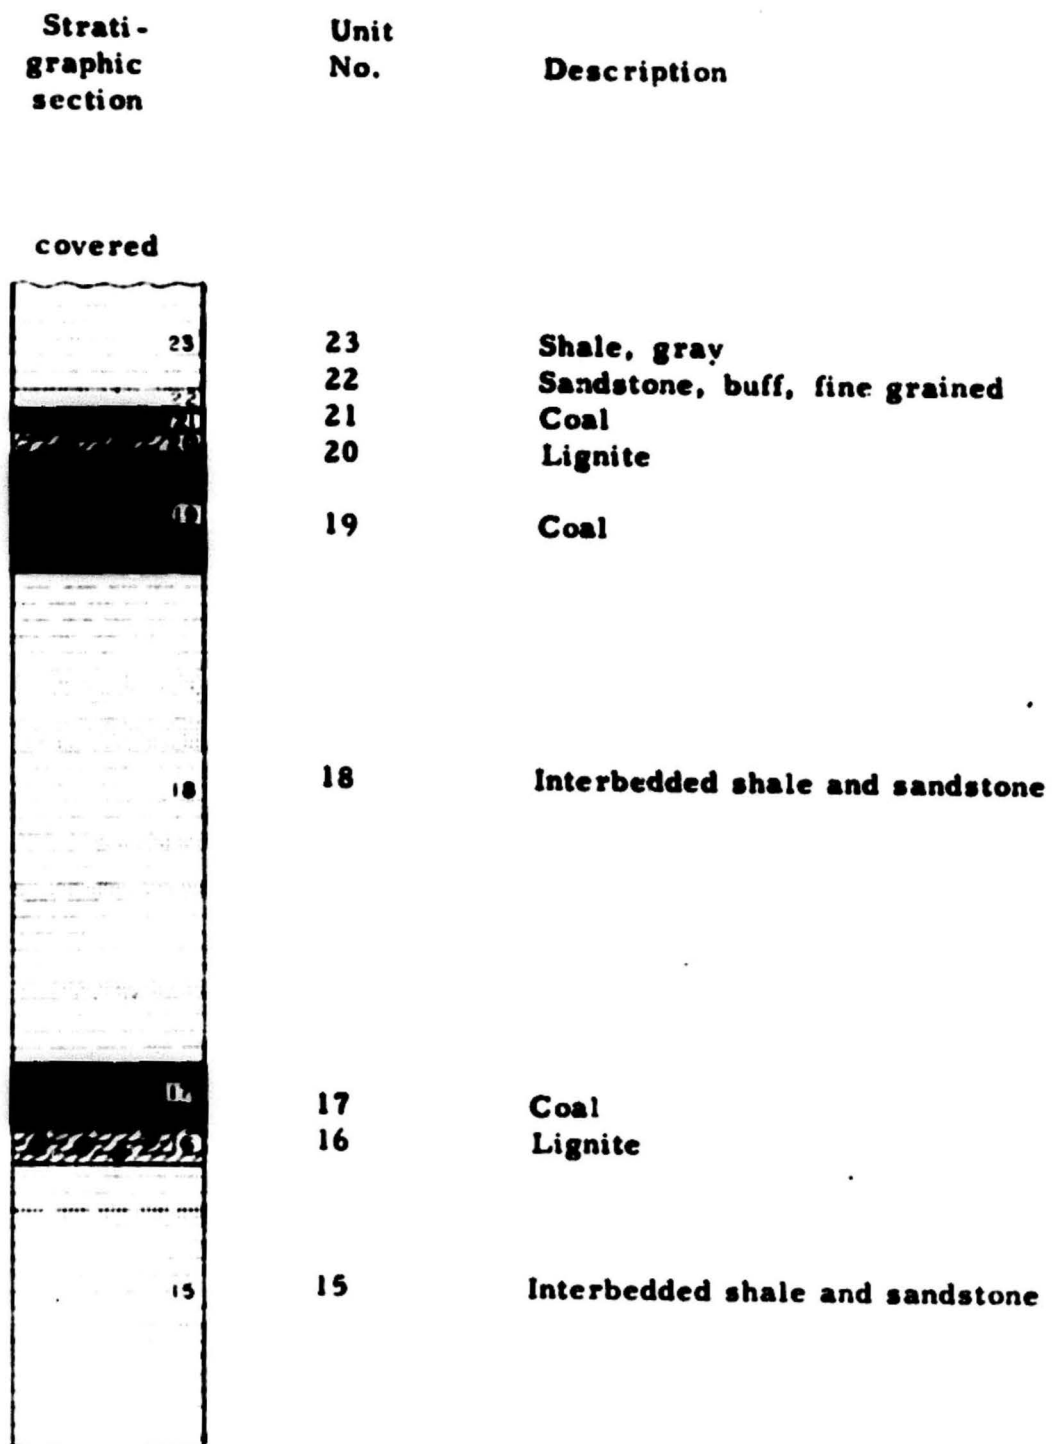

**Fig. 2.** Composite lithologic section of Laramie formation measured along right of way. Scale 1 inch equals 10 feet.

Fig. 2 (Cont'd)

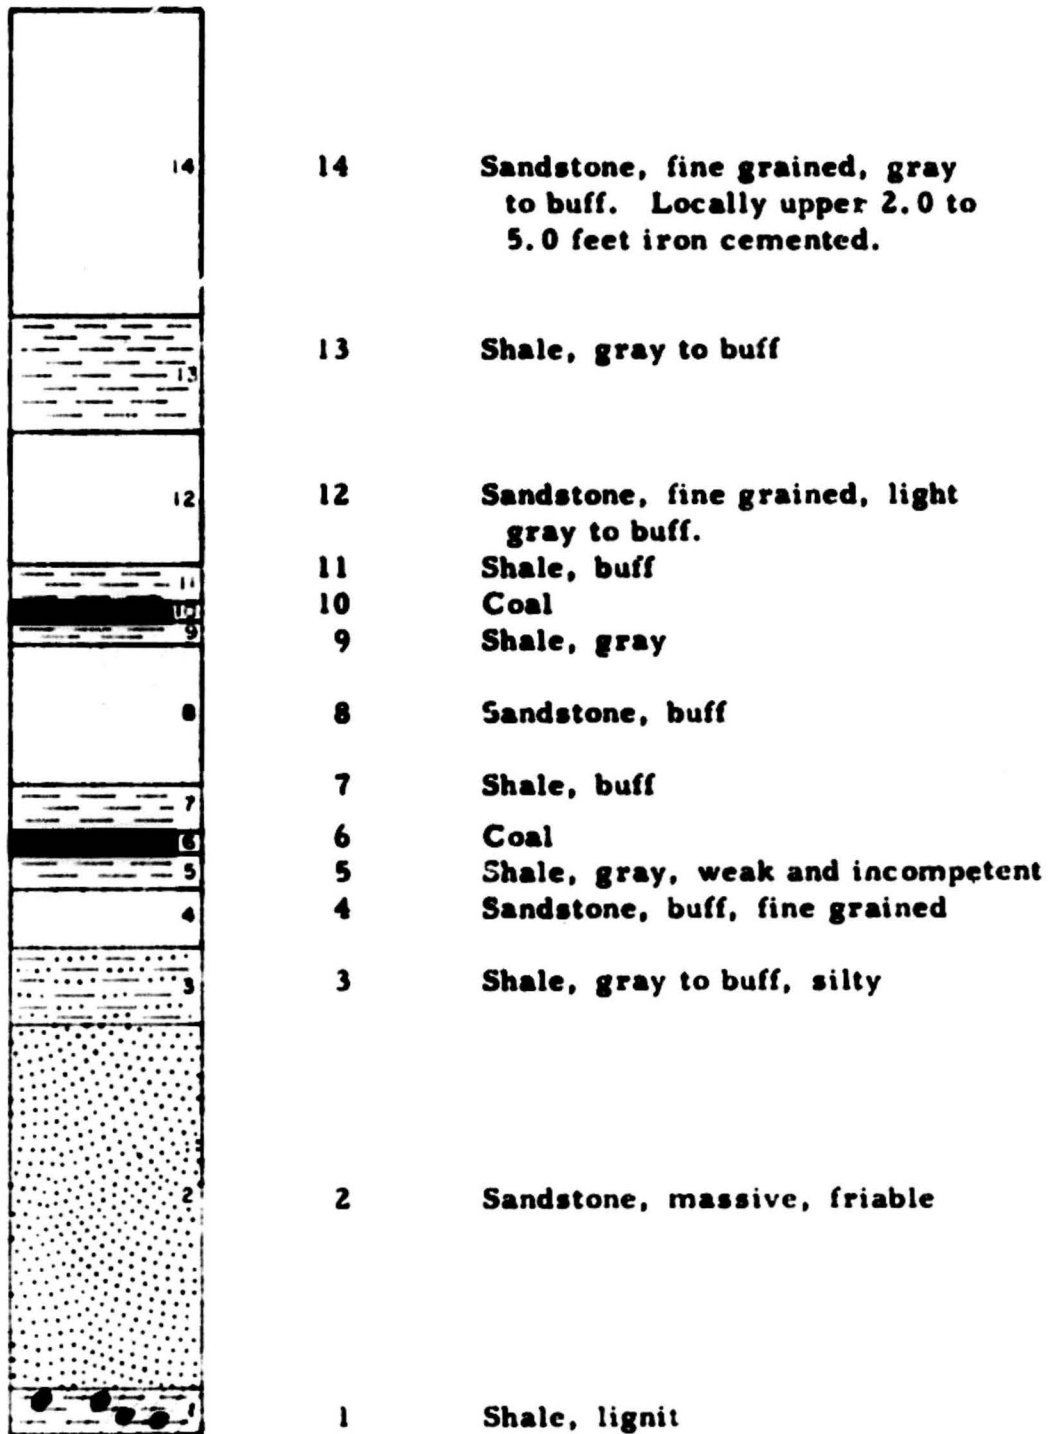

### Ground water conditions

Water entering and accumulating in permeable materials will in most cases cause considerable decrease in the stability of those materials. When this occurs in the sub-grade of a road it can decrease the stability of the sub-grade to such an extent that it will cause the pavement to fail under normal traffic loads. If montmorillonite clay minerals (Grim, 1953, p. 55) are present, the water will cause them to increase in volume which will cause rising and buckling of the pavement. In either case it is far more economical if these conditions can be anticipated and prevented during construction than to continually repair a road or attempt to rectify the condition after the road is completed.

A good example of the effect of clay expansion beneath a roadbed occurred about three miles east of Marshall on the Boulder-Denver Turnpike, which was completed in 1952, (Dobrovolsky, 1953, p. 46 ). Here the Laramie formation dips gently toward the subgrade allowing ground water to move along a coal seam and saturate an underclay containing montmorillonite. The clay expanded causing one end of a concrete slab to rise eight-tenths of a foot. This, naturally, would have a disastrous effect upon vehicles using the highway, so the State Highway Department has had to raise the adjacent slab by mud-jacking to meet this rise. Mud-jacking is an expensive process. Had this situation been anticipated and drains installed during construction it would have been far less costly than it has been to correct. On the Marshall-Rocky Flats relocation alignment it was determined that all formations, fortunately, dip away from the road and this situation is



**Plate 4. A. Looking back (north) from station 75 toward proposed cut from station 61 to 67. Center line of road lies to left of coal mine chute and tippie. B. After construction of same cut. Thick coal seam (Fig. 2.) is seen behind cars. Same seam is seen above coal tippie on southeast side of fault. Collapsed tunnel indicates strike of seam. Another fault occurring in gully on near side of mine tippie has offset coal causing mines to be abandoned.**




unlikely to occur/ <sup>because</sup> the more permeable lithologic units will tend to act as drains and lead water away from the road. However, the following ground water problem was present, but was not recognized by the Highway Engineers until it was pointed out to them in the geologic report.

There is little surface runoff from the pediment gravel. Water falling on the surface percolates down through the gravel until it reaches the bedrock surface. Because so much of the bedrock underlying <sup>the</sup> gravel is impervious (i.e. Pierre shale and shales of the Fox Hills sandstone and Laramie formation), the water migrates along the gravel-bedrock contact until it appears at the edge of the pediment in the form of springs and seeps. The bevelled bedrock surface as well as the gravel surface has a gentle dip to the northeast; therefore most of the water appears on the north and east edges of the pediments and terraces. The amount of water will fluctuate with the season, spring and summer having the maximum amounts.

Every place where the grade line of the road intersects the gravel-bedrock contact represents a potential source of trouble (Plates 5, 6). Near station 180, test pits were dug in the gravel by a cement company to test overburden thickness. The gravel here was nine feet thick. Many of these pits filled with water overnight to depths of as much as seven feet.



**Plate 5. A. Looking ahead (south) from station 82 toward proposed cut at station 90. Note springs in gully below edge of pediment. B. After excavation of same cut. Note pediment gravel-bedrock (Laramie) contact in left cut bank. Bedrock dips  $45^{\circ}$  to left (east).**

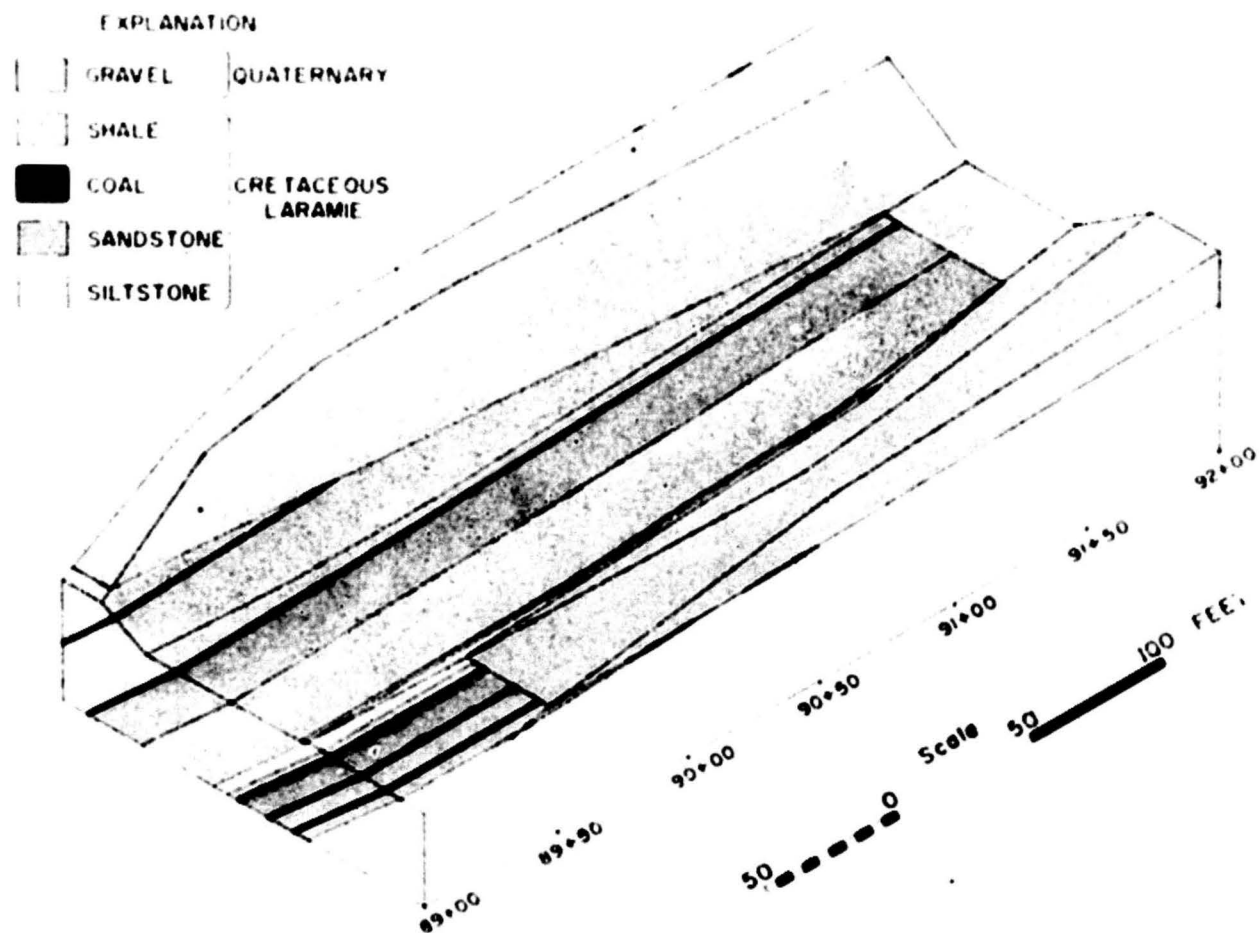

BLOCK DIAGRAM OF ROAD CUT FROM STATION 89+00 TO STATION 92+00

Water, migrating along the gravel-bedrock contact, reaching a pervious bedrock formation may percolate into this formation and seep out on the ground surface at some point on the edge of the pediment below the base of the gravel. An example is seen near station 90. The water seeps from the gravel-bedrock contact into a pervious sandstone of the Laramie formation and appears at the ground surface as a spring in a gully near the road. From the geological investigation it appeared that a lateral drain placed beneath the road, where the grade line intersects the gravel-bedrock contact, would intercept the ground water seeping into the sub-grade and also a large part of the water moving through the sandstone so that it would not come to the surface beneath the fill. The spring itself would be depleted and any water issuing from it would be intercepted by a ditch, thus protecting the fill from saturation.

### **Landslides**

Many small landslides are to be seen on the edges of the pediments in this area. They are of two types. The smaller slides generally involve only the surficial rubble that mantles the slopes bordering the pediments. In the larger slides bedrock also has been involved. They are lubricated by water from the seeps and springs that issue from the gravel-bedrock contact. An example of one of these large slides is south of the project where the road to Golden descends the pediment edge on the north side of Ralston Creek.



Plate 7. A. Looking back (north) from station 180 before excavation of cuts from station 166 to 183. Note Pleistocene terraces in valley of Coal Creek in middle distance  
 B. After excavation of same cuts. Foreground cut in Pierre shale capped by pediment gravel. Cut with trucks in arenaceous zone of Pierre shale capped by terrace gravel.

As the road descends into Ralston Creek Valley it traverses the surface of a large slide in the Laramie formation.

A slide occurred in a cut in the Pierre shale on the Marshall-Eldorado Springs road in the spring of 1953. An irrigation ditch just above the cut bank apparently supplied water which saturated the Pierre shale. When the cut was subsequently steepened by regrading, the stability of the material was upset and the slide occurred.

The relocated highway alignment will not be affected by major landslides.

#### Recommendations

Station 10+50 and 17+50 -- The contact between the capping gravel and the underlying Fox Hills sandstone will be intersected above the grade line and any water that might issue at the base of the gravel will effectively be carried in the ditches. Shaly zones are not anticipated in this cut, however, if they do exist, water deleterious to the road may be carried above the sandstone-shale contact and should be intercepted.

As the Fox Hills sandstone is evenly fine-grained and in this cut homogeneous, it may be considered to be isotropic in the sense that it will work the same in all directions. If shaly partings are present, they will alter this property to the extent that separation will take place more easily at the contact of sandstone with shale. The upper

5.0 feet or so are weathered which means the upper part will be removed with greater ease than the lower part. If the unweathered part of the sandstone is blasted, the material will pot out.

Surface observations reveal no cementation along the proposed center-line cut and it is believed that all of the material that will be removed will be "common excavation."

Station 23 to 28. -- Excavation will encounter sandstone, shale, and coal. Within a given unit the properties will, of course, be isotropic, but since the units alternate in lithology, i. e. , sandstone, shale, and coal, separation will take place along the planes distinguishing one kind of rock from another. Even though the sandstones may be hard, the entire cut is considered to be "common excavation" because of the alternation of thin layers of hard and soft rock.

Coal and particularly the underclay are weak and incompetent and if allowed to become wet will expand. As these rocks dip slightly to the left and the cut will be daylighted / on the right it is assumed

---

/ In this instance, the term "daylight" means making the cut slope horizontal on one side of a road cut. This is often done in road cuts on side slopes where there is a small amount of material to be removed. The material is used for fill elsewhere.

---

that moisture will not reach them. On the basis of existing knowledge, no sub-surface drainage is recommended.

Station 35 to 49. -- All excavation will be in fine-grained sandstone. Along some portions of the center line the upper 2 to 4 feet have been iron cemented. The iron cemented part will work more or less as a unit. The sandstone below the cemented part will be harder to remove than the Fox Hills sandstone. Locally, however, it was possible to penetrate it two to three feet with a post hole auger.

All of the sandstone that has been iron cemented is "rock excavation." Approximately 4 feet below the top of the sandstone the material is considered to be "common excavation." It was not possible to verify this belief, but observations made at the surface indicate that such an interpretation is rational.

The surface of the sandstone is irregular because underlying coal seams have been burned out, causing collapse of the sandstone.

Station 49 to 52/12. -- Excavation will be in part in the same sandstone that is present from station 35 to 49. It will also include a shale below that sandstone. As it was possible to penetrate the sandstone at station 52/12 to a depth of 12 feet with an auger, it is not very hard. The materials are considered to be "common excavation" except for the small quantity of iron cemented sandstone that will be removed from the top part of the cut on both the right and left side.

On the basis of present knowledge, drains are not recommended.'

Station 52/12 and 53/00. -- Geology is not shown on the profile between station 52/12 and 53/00. This is because the precise



location of a fault which passes through center-line was not definitely established. Beds adjacent to the fault are somewhat distorted and without additional investigation cannot be accurately delineated. Materials that will be excavated are sandstone and shale. As the sandstone does not appear to be well cemented, all of the materials that will be moved are classified as "common excavation."

Station 61 to 67. -- The sequence of rocks that will be encountered is represented on the attached natural scale profile (Plate 21).

The sandstone shown at the surface at station 65  $\neq$  50 has been cemented by silica. The distribution of silicification in this sandstone is imperfectly understood, but it is believed to pervade so much of it that the entire unit is classified as "rock excavation." All other rock units shown above grade line will be "common excavation."

The beds at station 61  $\neq$  50 and at 65  $\neq$  00 have been distorted because of collapse resulting from mining or burning of the underlying coal. For that reason, and also because faults of small displacement may be present, some of the contacts as shown may be in error.

Station 75 to 81  $\neq$  50. -- The cut will be in weak and incompetent shales, sandstones, lignites, and coal. They represent a part of the geologic column that was established by augering because they are everywhere concealed by a thin mantle of colluvium. All material in this cut is "common excavation."

The rocks dip to the left. Because the rocks contain clay minerals that expand upon wetting and because aquifers in the form of sandstones

are present, drains are recommended. As the only entrance of water to the roadway is from right to left in conformity with the structure, subsurface drains are suggested for the right shoulder only. They should extend throughout the length of the cut on the right side. To be certain of intercepting all the water, stub drains are suggested for the right side of stations 76/50, 77/00, and 80/75. These should connect with the right longitudinal drain.

Stations 89 to 96. -- The upper part of the excavation will be in Tertiary(?) gravel and the lower part will be in weak sandstones and shales of the Laramie formation. All material in this cut will be "common excavation."

Adequate control data for determining the precise elevation of the contact between the gravel and the Laramie formation at the grade line was not secured. However, the deviation from the point shown will be relatively small and will affect the hydrology problem only in location. Water in small quantities will be encountered at about station 91/50. It should be intercepted by drains before it reaches the grade line. Recognizing that the location may have to be altered, the following is suggested. A lateral drain should be placed at station 92/00. This lateral which will intercept most of the water should connect with longitudinal drains on each shoulder of the road. The longitudinal drains should extend from station 92/00 to station 90/50 where they may empty into the ditch line.

Station 100/00 to 107/00. -- The overlying materials are Tertiary to Pleistocene gravels and the underlying material is shale of the Laramie formation. In this place the gravel is underlain by fine sand. All material in this cut will be "common excavation."

Penetration by auger to a depth of twenty feet at station 104 and 106 has proved conclusively that the lower part of the gravel, all of the sand, and the top of the shale are water saturated. The top of the shale has been altered because of this almost continual saturation. A zone of accumulations of secondary lime exists in and on top of the shale. Two alternate suggestions are offered for interception of sub-surface water.

The first suggestion is: a lateral drain should be installed at about station 102/00. This lateral should be connected with longitudinals in each shoulder of the road. The longitudinal drains should extend to about station 107/00. A second lateral, also connecting with the longitudinals, might be placed at station 104/00.

The alternate suggestion is: excavate the ditches to a greater depth than now planned and have ditches serve as drains. In this place it is possible to eliminate sub-surface drains because the source of the water is mainly overflow in the gravel from the valley at station 98/00. If this suggestion is followed, it is recommended that the ditches only be cut about two feet lower than is now planned. This area between the road shoulders should not be cut lower than now planned. To cut lower than now designed and then backfill to grade will produce a contact along which water will move.

If the suggestion that the ditches serve as drains is followed, the outer sides of the ditches will be almost permanently moist and during rainy seasons may be saturated.

The determination of which of the two alternative methods should be used will be based on a comparison of (1) cost of moving larger quantities in excavating deeper ditches and (2) cost of installing standard sub-surface interception drains.

Station 120 to 125. -- Excavation will be entirely in gravel.

As the base of the gravel will not be cut, drains are not recommended.

Station 139 to 144. -- Excavation will be in gravel, Pierre shale, and Fox Hills sandstone. All materials are classified as "common excavation."

As the Fox Hills sandstone is porous probably it will carry any water that might be present in the gravels. Drains are not recommended on the basis of existing information.

Station 166 to 173. -- Excavation will be in gravel and Pierre shale and is classified as "common excavation."

As contact between the gravel and the Pierre shale will be above the grade line, surface ditches will be adequate to carry any water that issues from the contact. Very little water is expected because the catchment area is so small.

On the left side of the cut between station 168 and 171, a sand composes the lower part of the gravel. The expectable yardage is

estimated to be approximately 2,000 yards. Additional testing will be necessary to determine its specific use, if any.

Station 178 to 186. -- Part of the excavation will be in gravel and part in Pierre shale. These materials are classified as "common excavation."

About sixty feet to the left of station 186 a pit excavated to a depth of 9 feet has, after opening, filled with water to within 2.3 feet of the surface. Because of channeling on top of the Pierre shale the gravel may not carry quite so much water at station 180 where the grade line intersects the contact. However, as the Pierre shale contains expansive clay minerals, even a small addition of water will cause swelling. Therefore, drains should be installed to keep the sub-grade dry. A lateral drain should be installed on the right at station 180+50 and connected with a longitudinal extending to about 179+00. As the left side of the cut will be daylighted the opening of the lateral may be in the left ditch.

Station 201 to 205. -- The contact between the gravel and the Pierre shale is well exposed in the ditch line of the existing road. The materials are classified as "common excavation."

A lateral drain is recommended at about station 204 to 205 connected with longitudinals extending to about 204.

### **PART III**

#### **Conclusions**

Many phases of geology are called upon in the solution of engineering problems. Among the phases used in this investigation were: structural geology, sedimentology, stratigraphy, geomorphology, lithology, and hydrology.

Rarely will any one project be able to utilize more than a few of the geological services listed by Huntting (1945, p. 272). As a result of this investigation, geologic information will contribute to an overall reduction in costs by providing a basis for:

1. Predicting the material to be excavated thus preventing any serious error in bidding. Knowledge of the geology will eliminate much of the risk involved in bidding for either the State or the contractor.
2. Predicting where ground water problems will be encountered and recommending possible solutions to the problem. This will contribute to the length of life of the road and thus reduce maintenance costs.
3. Predicting sub-grade stability which will also reduce maintenance costs.
4. Predicting the presence or absence of potential or actual landslides.
5. In conjunction with No. 1 above, determining the type of material that will be used in fills.

The works of the engineer are becoming increasingly larger and more complex and therefore he is obliged to call upon more and more types of technical assistance in planning and construction. Geology is one of the valuable tools that can materially aid in the solution of many engineering problems.

### Bibliography

- Anonymous, 1936, Annotated catalogue of unpublished engineering and geologic reports on mineral resources of Colorado: Colo. State Planning Commission, 47 p., Dec. 1936
- \_\_\_\_\_. 1945, Report of the committee on geological surveys: American Ceramic Soc. Bull., v. 24, p. 234-245.
- Bailar, J. C., 1911, Non-metallic minerals of Colorado: Colo. School of Mines Biennial Report, 1908, 1909, 1910, 1911.
- Brown, R. W., 1943, Cretaceous-Tertiary boundary in Denver Basin, Colorado: Geol. Soc. of America Bull., v. 54, no. 1, p. 565-586.
- Burwell, E. B., Jr., and Roberts, G. D., 1950, The geologist in the engineering organization: Berkey Volume, p. 1-9, Geol. Soc. America.
- Butler, G. M., 1915, Clays of eastern Colorado: Colo. Geol. Survey, Bull. 8.
- Campbell, M. R., 1922, Guidebook to the western United States, Part E: U. S. Geol. Survey, Bull. 707.
- Chelikowsky, J. R., 1935, Geologic distribution of fire clays: American Ceramic Soc. Jour., v. 18, no. 12, p. 367-390.
- Cobban, W. A., and Reeside, J. B., 1952, Correlation of the Cretaceous formations of the western interior: Geol. Soc. of America Bull. v. 63, no. 10, p. 1011-1043.



- Dane, C. H., Pierce, W. G., and Reeside, J. B., 1937, The stratigraphy of the Upper Cretaceous rocks north of the Arkansas River in eastern Colorado: U. S. Geol. Survey Prof. Paper 186k.
- Dobbin, C. E., and Reeside, J. B., 1930, Contacts of the Fox Hills and Lance formations: U. S. Geol. Survey Prof. Paper 158.
- Dobrovolsky, Ernest, 1953, Results obtained on specific projects, The 26th Annual Highway Engineering Conference: Univ. of Colo.
- Emmons, S. F., Cross, C. W., and Eldridge, G. H., 1896, Geology of the Denver Basin: U. S. Geol. Survey Mon. 27.
- Fenneman, N. M., 1905, Geology of the Boulder district: U. S. Geol. Survey Bull. 265.
- \_\_\_\_\_, 1931, Physiography of the western United States: New York, McGraw-Hill Book Co., Inc.
- Goddard, E. N., and Lovering, T. S., 1937, Laramide fault pattern of the Front Range, Colorado: Mines Mag., v. 27, no. 7, p. 9-11.
- Geijshbeek, Samuel, 1906, Whiteware possibilities of Colorado: American Ceramic Soc. Trans. v. 8, p. 98-108.
- Griffitts, M. C., 1949, Zones of Pierre formation of Colorado: American Assoc. Petroleum Geologists Bull., v. 33, no. 12, p. 2011-2028.
- Grim, R. E., 1953, Clay Mineralogy: New York, McGraw-Hill Book Co., inc.
- Gude, A. J., 3rd, 1950, Clay minerals of the Laramie formation, Golden, Colorado, identified by x-ray diffraction: American Assoc. Petroleum Geologists Bull. v. 34, no. 8, p. 1699-1717.

- Gude, A. J. 3rd, and McKeown, F. A., 1952, Results of exploration at the old Leyden Coal Mine, Jefferson County, Colorado: U. S. Geol. Survey T. E. M. Report 292.
- Hayden, F. V., 1868, Rocky Mountain coal beds: American Jour. Sci., 2nd Ser., v. 45, p. 101-102.
- \_\_\_\_\_, 1873, 1st, 2nd, and 3rd annual reports of the U. S. Geol. Survey of the territories for 1867, 1868, 1869, p. 129-137.
- Hendricks, S. B., 1942, Lattice structure of the clay minerals and some properties of clays: Jour. Geology, v. 50 no. 3, p. 276-290.
- Hill, R. T., 1889, Roads and materials for their construction in the Black Prairie region of Texas: Texas Univ. Bull.
- Horner, S. E., and McNeal, J. D., 1950, Applications of geology to highway engineering: Colo. School of Mines Quart., v. 45, no. 1B, p. 155-186.
- Horner, S. E., and Dobrovolsky, Ernest, 1952, Application of geology to highway work as practiced by the States, a questionnaire summary (Abs.): Third Annual Symposium on Geology as Applied to Highway Engineering, Va. Dept. of Highways and Va. Military Institute, Lexington, Va.
- Hunter Z. M., 1947, Geologic pattern in the foothills of the Front Range, Boulder-Lyons area, Colorado: Unpublished Thesis, Univ. of Colo.

- Huntting, M. T., 1945, *Geology in highway engineering*: Trans. American Soc. Civil Engineers, v. 110.
- Irwin, J. S., 1926, *Faulting in the Rocky Mountain region*: American Assoc. Petroleum Geologists Bull., v. 10, no. 2, p. 105-129.
- Johnson, J. F., 1935, *Geology of the Marshall District, Colorado*: Unpublished Thesis, Univ. of Colo.
- Johnson, J. H., 1923, *Bibliography of Geology of the Denver Basin, Colorado*: Colo. School of Mines Circular Information, 7 p.
- Knowlton, F. H., 1914, *Cretaceous-Tertiary boundary in the Rocky Mountain region*: Geol. Soc. America Bull., v. 25, p. 325-340.
- \_\_\_\_\_, 1922, *The Laramie flora of the Denver Basin, with a review of the Laramie problem*: U. S. Geol. Survey Prof. Paper 130.
- Lakes, Arthur, 1889, *The geology of Colorado coal deposits*: Colo. School of Mines Annual Report of Field Work.
- \_\_\_\_\_, 1891, *The fuel resources of Colorado*: American Geol. v. 8, p. 7-19.
- \_\_\_\_\_, 1904, *Coal fields of Colorado*: Colo. School of Mines Bull. v. 2, no. 2, p. 1-23.
- Lavington, C. S., 1933, *Montana group in eastern Colorado*: American Assoc. Petroleum Geol. Bull., v. 17, no. 4, p. 397-410.
- \_\_\_\_\_, and Thompson, W. C., 1948, *Post-Mississippian Stratigraphy*: Colo. School of Mines Quart., v. 43, no. 2, p. 36-52.

- Legget, R. F., 1939, *Geology and engineering*: New York, McGraw-Hill Book Co., Inc.
- LeRoy, L. W., 1946, *Stratigraphy of the Golden-Morrison area, Jefferson County, Colorado*: Colo. School of Mines Quart., v. 41, no. 2
- Lovering, T. S., et al, 1932, *Fox Hills formation, northeastern Colorado*: American Assoc. Petroleum Geologists Bull. v. 16, no. 7, p. 702-703.
- \_\_\_\_\_, and Goddard, E. N., 1950, *Geology and ore deposits of the Front Range, Colorado*: U. S. Geol. Survey, Prof. Paper 223.
- Moody, J. B., 1947, *Upper Montana Group, Golden area, Colorado*: American Assoc. Petroleum Geologists Bull. v. 31, no. 8, p. 1454-1471.
- Paige, Sidney, 1950, *Application of geology to engineering practice*: Berkey Volume, Geol. Soc. America.
- Reichert, S. O., 1954, *Geology of the Golden-Green Mountain area, Jefferson County, Colorado*: Colo. School of Mines Quart., v. 49, no. 1.
- Ries, Henrich, and Watson, T. L., 1936, *Engineering geology*: New York, John Wiley and Sons.
- Robb, G. L., 1948, *Quaternary pediments in the Golden area (Abs.)*: Colo.-Wyoming Acad. Sci. Jour., v. 3, no. 5, p. 37.
- Spencer, F. D., and Erwin, M. I., 1953, *Coal resources of Colorado*: U. S. Geol. Survey Circular 258.

- Van Tuyl, F. N., and Lovering, T. S., 1935, Physiographic development of the Front Range: Geol. Soc. America Bull. v. 46, p. 1291-1330.
- \_\_\_\_\_, et al, 1938, Guide to the geology of the Golden area: Colo. School of Mines Quart. v. 33, no. 3, p. 1-33.
- Waage, K. M., 1953, Refractory clay deposits of south-central Colorado: U. S. Geol. Survey Bull. 993.
- Wahlstrom, E. E., 1947, Cenozoic phystographic history of the Front Range, Colorado: Geol. Soc. America Bull., v. 58, no. 7, p. 551-572.
- Waldschmidt, W. A., 1939, The Table Mountain lavas and associated igneous rocks near Golden, Colorado: Colo. School of Mines Quart., v. 34, no. 3.
- Willmarth, M. G., 1938, Lexicon of geological names in the United States (including Alaska): U. S. Geol. Survey Bull. 896, (2 par )
- Winterkorn, H. F., 1942, Applications of modern clay researches in construction engineering: Jour. Geol., v. 50, no. 3, p. 291-300.
- Woodbury, H. O., 1942, Structure of the "Boulder Arch," Boulder, Colorado: Unpublished Thesis, Univ. of Colo
- Worcester, P. G., 1931, Peneplanation and base-leveling in the Rock Mountains (Abs.): Colo. -Wyoming Acad. Sci. Jour., v. 1, no. , p. 27-28.

Worcester, P. G., 1938, Pediments and related erosional forms of  
Colorado Front Range (Abs.): Geol. Soc. America Proc. 1937,  
p. 313.

\_\_\_\_\_, 1939, A textbook of geomorphology: New York, D. Van  
Nostrand Co., Inc

# Explanation of Plates 10 through 63

## Plate 8

Plates 10 through 21 are copies of the State Highway Commission's plan and profile sheets reduced to 1 inch equals 200 feet horizontal scale and one inch equals 20 feet vertical scale. The upper half of each sheet shows the plan of the highway alignment. No geology is shown on the plan. For the geologic map the reader is referred to Plate 1.

The lower half of each sheet shows the profile of the highway center line with the geology added. Along the bottom of the profile every fifth station is numbered and on either end of the profile the altitude above sea level is shown.

The following conventional engineering signs and symbols are the only ones essential to a basic understanding of the plan and profile.

### Plan Symbols

Center line —————  
 Right of way line - - - - -  
 County line - - - - -  
 Township or range line - - - - -  
 Section line —————  
 Quarter section line —————  
 Barbed wire fence — — — — —  
 Telephone line    ◊    ◊    ◊  
 Power line        ●    ●    ●    ●  
 Present road    =====


### Profile Symbols

Ground line - - - - -  
 Highway grade  
 (center line) —————


Plates 22 through 63 show reductions of the cross sections made by the state highway engineers at every 50 & 100 foot stations. The geology has been added to the more important of these cross sections. The scale is one inch equals ten feet both horizontally and vertically.

The following conventional engineering signs and symbols are the only ones necessary to a basic understanding of the cross sections. Cross sections are always made looking "ahead" (see p.    ) along the center line.

### Cross Section Symbols

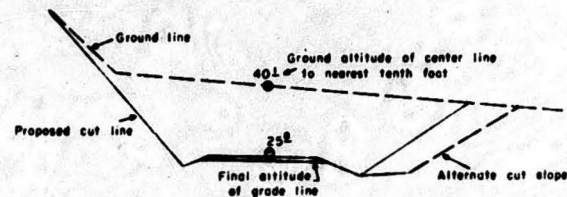

LOCATION OF PLATES 10 THROUGH 21 ON HIGHWAY ALIGNMENT

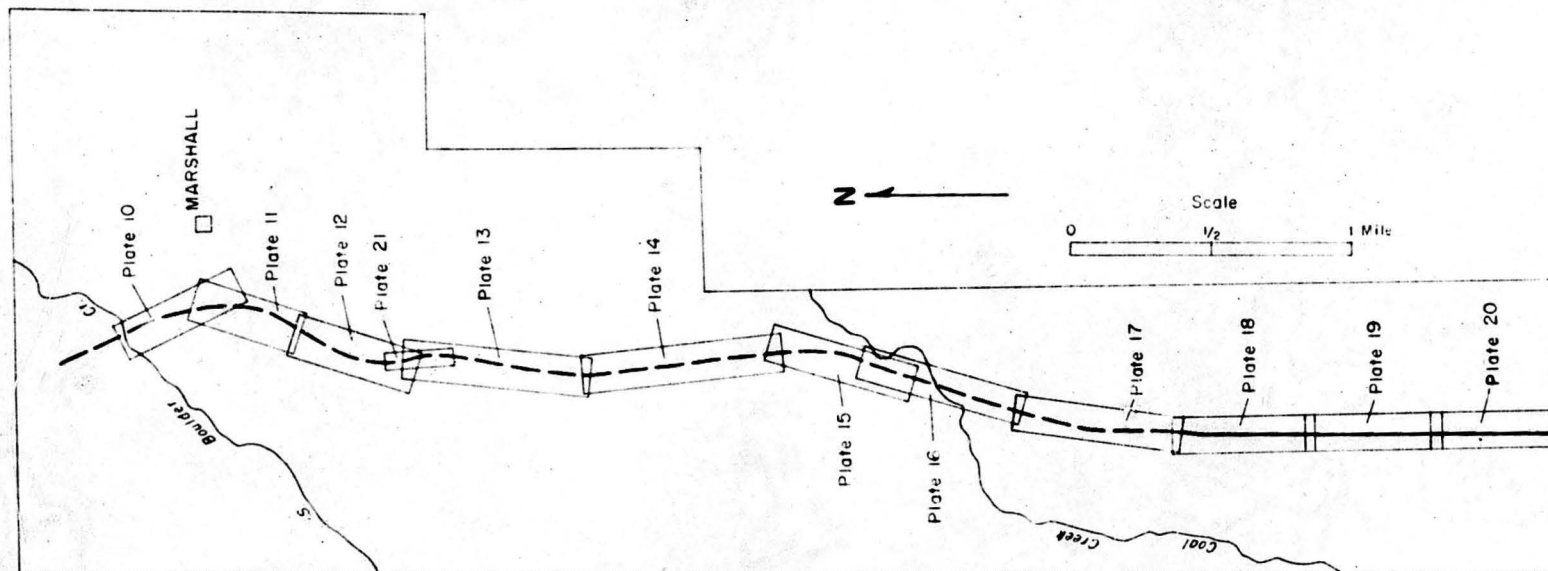




# COLORADO DEPARTMENT OF HIGHWAYS

## PLAN AND PROFILE OF PROPOSED FEDERAL AID PROJECT NO. AA-13 UNIT 1 STATE HIGHWAY NO. 93 BOULDER AND JEFFERSON COUNTIES

### SCALES OF ORIGINAL TRACINGS

ON PLAN, 1 IN. = 100 FT.  
ON PROFILE, 1 IN. = 100 FT. HORIZONTAL  
1 IN. = 10 FT. VERTICAL  
GRADE LINE ON PROFILE TO CENTER OF GRADE OF FINISHED ROAD  

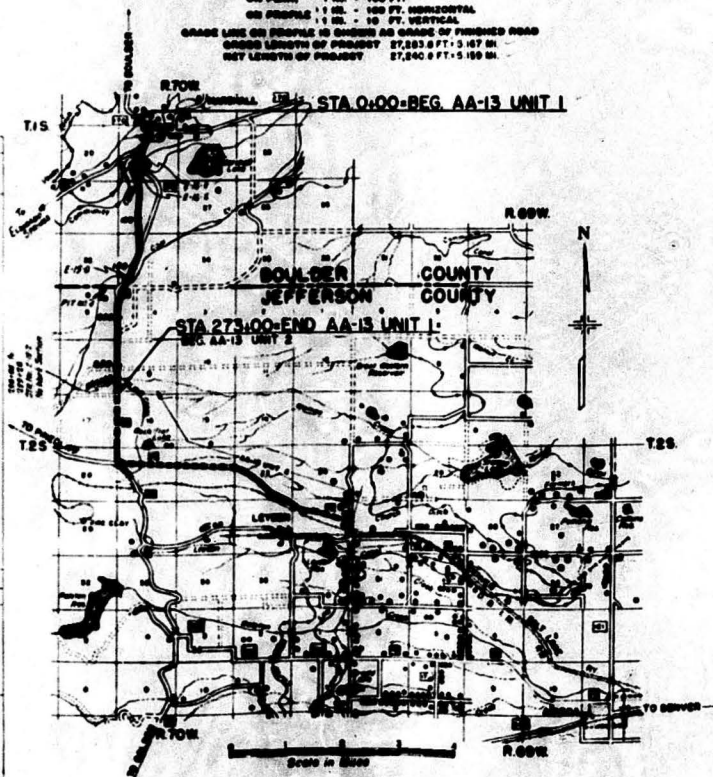

### CONVENTIONAL SIGNS

CENTER LINE OF SURVEY  
RIGHT OF WAY LINE  
COUNTY LINE  
TOWNSHIP OR RANGE LINE  
SECTION LINE  
QUARTER SECTION LINE  
RAILROAD  
BARBED WIRE FENCE  
SHOW FENCE  
TELEPH. & TELES. LINE  
POWER LINE  
PRESENT ROAD (PLAN SHEETS)

U. S. GEOLOGICAL SURVEY

### NOTICE TO BIDDERS

It is recommended that bidders on this Project go over the plan details with one of the following field representatives of this Department:  
Stan McEwen, Construction Engineer,  
Denver, Colorado.  
Paul R. Morley, Resident Engineer,  
Denver, Colorado.

COLORADO  
DEPARTMENT OF HIGHWAYS

APPROVED:  
Frank J. McIntire, S.E.  
CHIEF ENGINEER  
DATE

DEPARTMENT OF COMMERCE  
BUREAU OF PUBLIC ROADS

APPROVED:  
DISTRICT ENGINEER  
DATE

### INDEX OF SHEETS

- Sheet No. 1: Station Map, Title Page and Tabulation of Length and Design Data.  
2: Typical Section, General Notes and Special Details.  
3: Summary of Approximate Quantities.  
4: Fencing, Sub-Base Material, Surfacing, R.O.W. Markers & Timber Guard Posts.  
5: PI Location.  
6-7: List of Structures.  
8: Details of Bridge, Sta. 158+.  
9: Standard Concrete Box Culvert (Spt. Rev. Sta. M-104-G).  
10: Standard Letters & Figures for Year Numbers & Structure Numbers M-10-B.  
11: Standard Marker Posts M-7-B.  
12: Standard Headwalls and Aprons for CMP Culverts M-102-G.  
13: Standard Concrete Box Culvert M-104-G.  
14: Standard Timber Guard Posts M-19-D.  
15: Standard Wire Fence with Wooden Posts M-24-H.  
16: Standard Picket Stone Fence with Steel Posts M-25-B.  
17: Standard Methods for Super-elevation & Widening of Curves M-1-B.  
18: Standard Side Approach Roads, Flaring, Cut Slope Treatment & Widening of Bridges & at Crest of Grades M-2-DM.  
19: Standard Roadway Construction Traffic Signs M-29-A.  
20: Standard Types of Ditches and Construction Methods M-107-C.  
21-31: Alignment Plan and Profile.  
32-163: Cross Sections.  
164: Summary of Earthwork Quantities.  
165: Special 6x7 Concrete Box Culvert for Stock Pass M-10-D.  
316: Geologic Profile between Sta. 61+00 to 67+00.

### TABULATION OF LENGTH AND DESIGN DATA

STATION	ROADWAY	BRIDGES		Loading
	Lin. Ft.	Lin. Ft.	NO WORK	
<u>BOULDER COUNTY</u>				
0+00 BEGIN AA-13 UNIT No 1				
131+94.6 Bk. Elevation 123+31.0 Ah	13,194.4			
157+80.5 Bridge 158+33.0	2,649.0	52.5		H-18-44
158+91.0 Bk. Elevation 158+100.0 Ah	58.0			
168+78.8 County Line	979.8			
<u>JEFFERSON COUNTY</u>				
205+82.4 Bk. Elevation 208+52.5 Ah	3,702.6			
258+185 Bridge 259+25	5,032.5		430	H-18-44
273+00 END AA-13 UNIT No 1 BEG. AA-13 UNIT No 2	1,372.0			
TOTALS	27,188.3	52.5	430	
SUMMARY				Lin. Ft.    Miles
AA-13 UNIT No 1: ROADWAY - BOULDER COUNTY				17,081.2    3.235
AA-13 UNIT No 1: BRIDGES - BOULDER COUNTY				52.5    0.010
AA-13 UNIT No 1: ROADWAY - JEFFERSON COUNTY				10,107.1    1.914
NO WORK SECTION				430    0.008
TOTAL AA-13 UNIT No 1: GROSS LENGTH				27,283.8    5.167
TOTAL AA-13 UNIT No 1: NET LENGTH				27,240.8    5.159
DESIGN DATA				
MAXIMUM DEGREE OF CURVE		3°00'		
MAXIMUM GRADE		7.00%		
MINIMUM NPSS - horizontal		465'		
MINIMUM NPSS - vertical		465'		
MAXIMUM DESIGN SPEED		50 M.P.H.		

**NOTE:**

Alignment and Grades as shown are subject to modification during construction after approval by the District Office.  
Soil data shown on the plans is obtained from local available testing laboratory information. This information is shown for convenience of the Contractor and the Department does not guarantee the accuracy of these data. If materials not conforming to the data on plans, are encountered during construction, the grading plan shown on plans, will be modified where necessary to secure dense, stable embankments.



Passing, ROW Markers, etc. are tabulated on Sheet No. 4.

Rev. 7-19-53-AMC- Road Approach, L.I. Sta. 20



REV. NO.	DATE	BY	CHKD. BY	APP. BY
0	0000	AA-13	SI	

Rev. 6-29-53, Survey 0000, L.I. R.  
Rev. 5-3-54, Survey, J.E.R.


U. S. GEOLOGICAL SURVEY

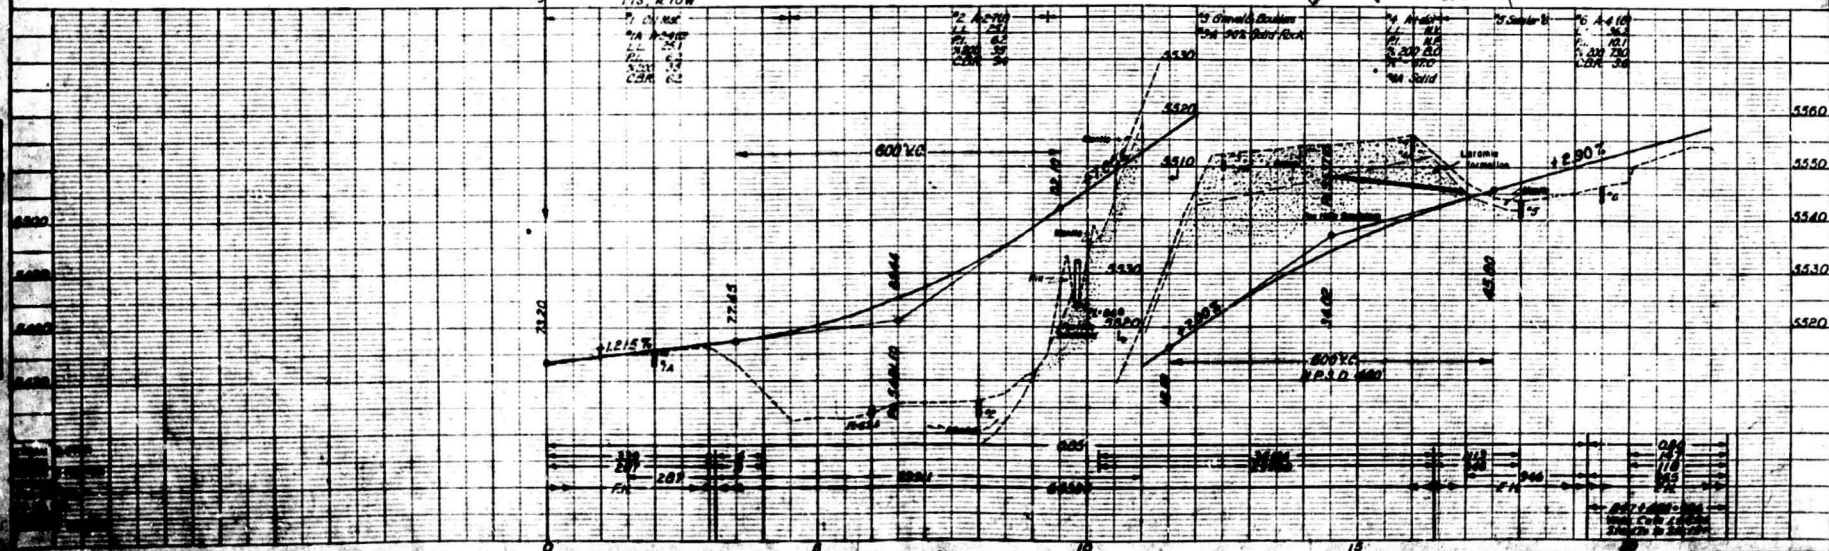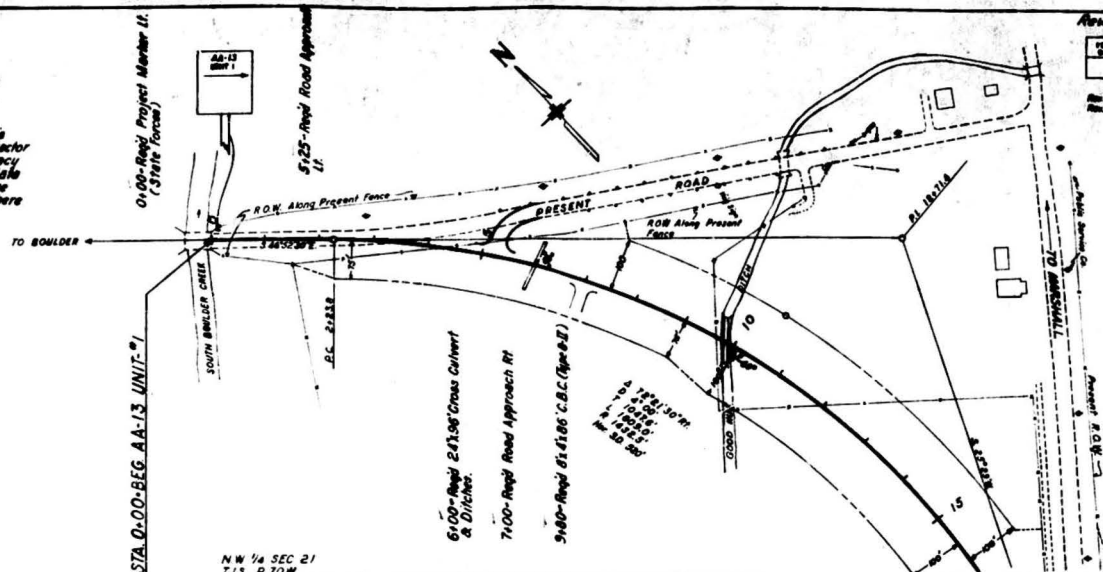

FED ROAD DIST NO	DIST	PROJ NO	SHEET NO	TOTAL SHEETS
9	COLO	AA-13 UNIT-1	22	

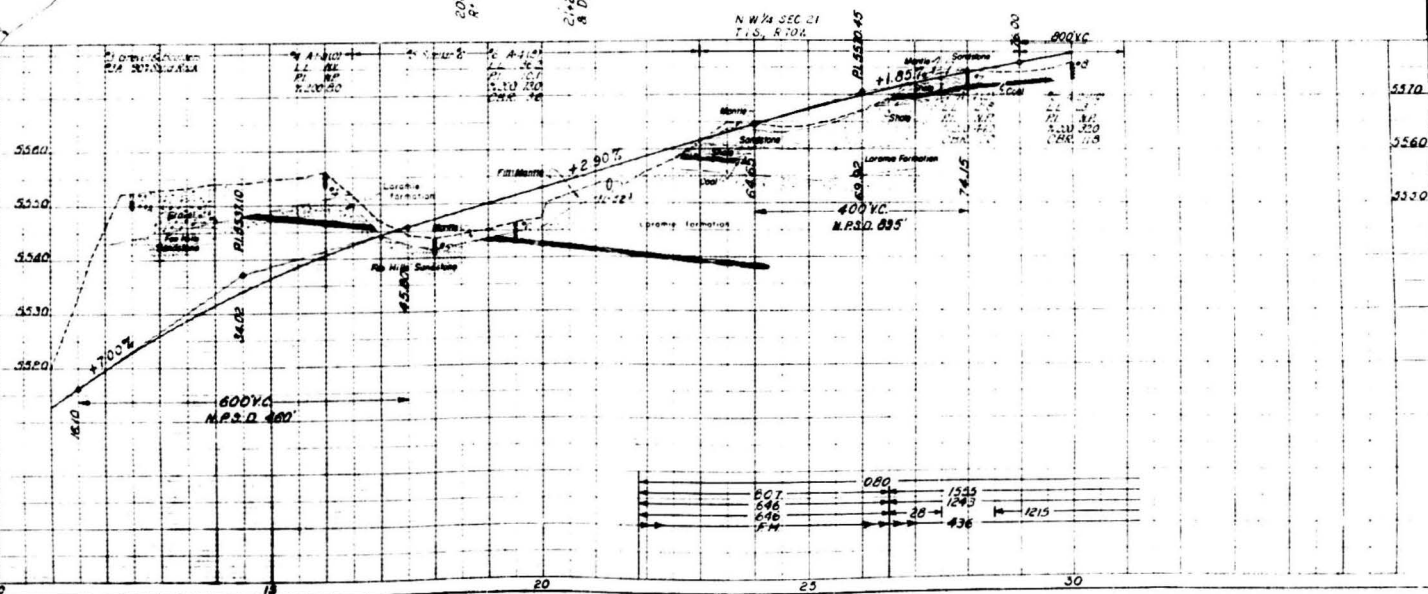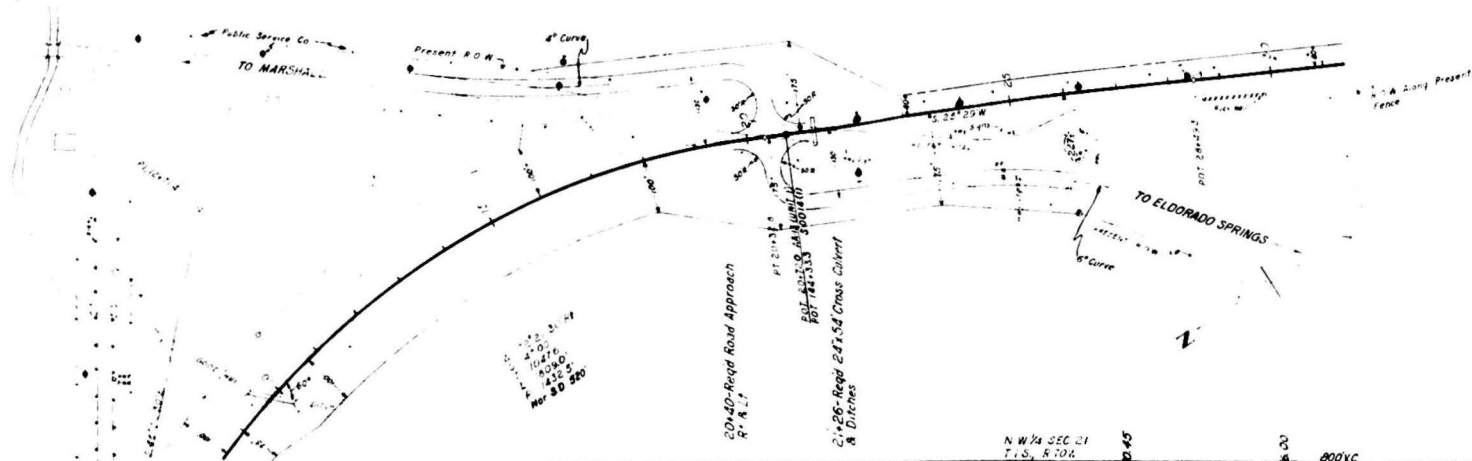

KENNY MOTOR  
KENDY  
KENNY & HUBER  
KENNEDY  

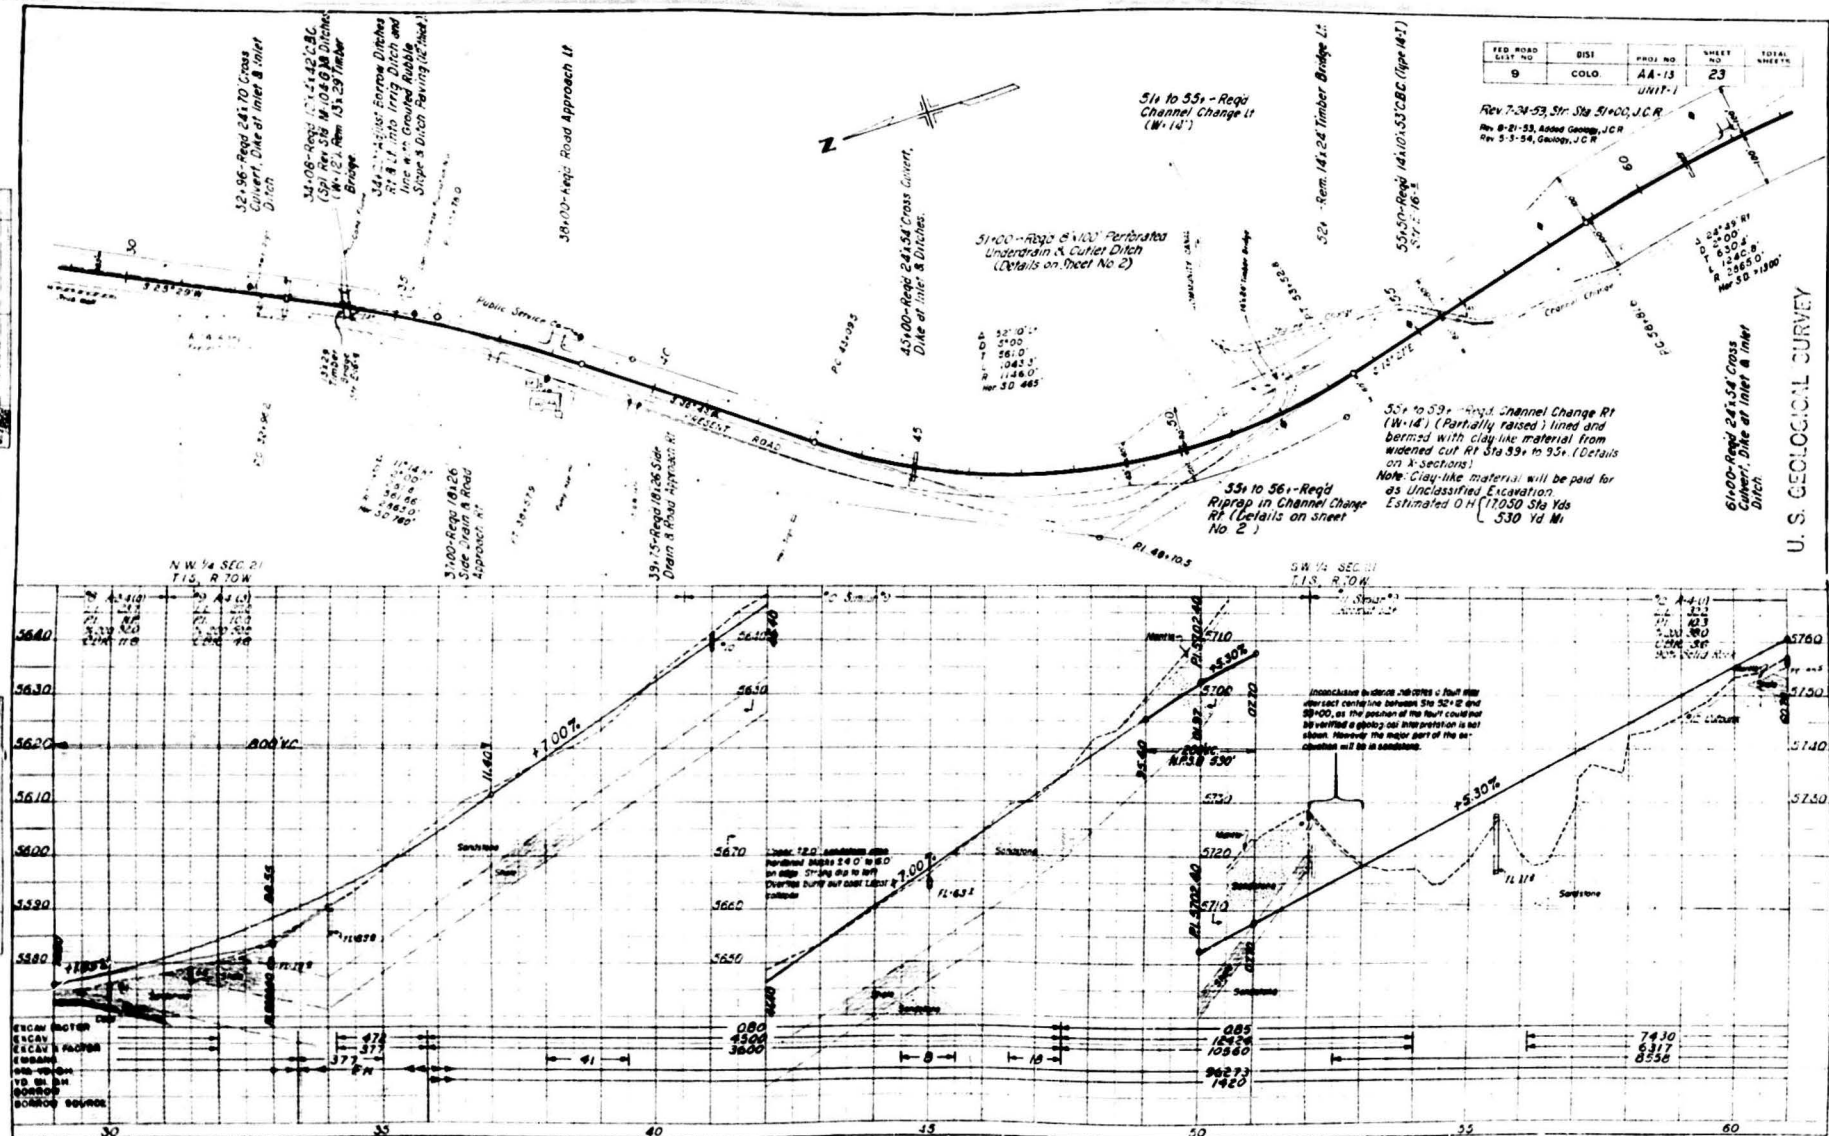

U. S. GEOLOGICAL SURVEY




FED ROAD DIST NO	DIST.	PROJ NO.	SHEET NO	TOTAL SHEETS
9	COLO.	AA-13	24	

Rev 9-21-53, Added Geology, J.C.R.  
Rev 5-3-54, Geology, J.C.R.

## UNIT-1

A 23°35'41"  
D 2°00'  
T 398.1'  
L 1179.2'  
R 2865.0'  
Mer 50 730"

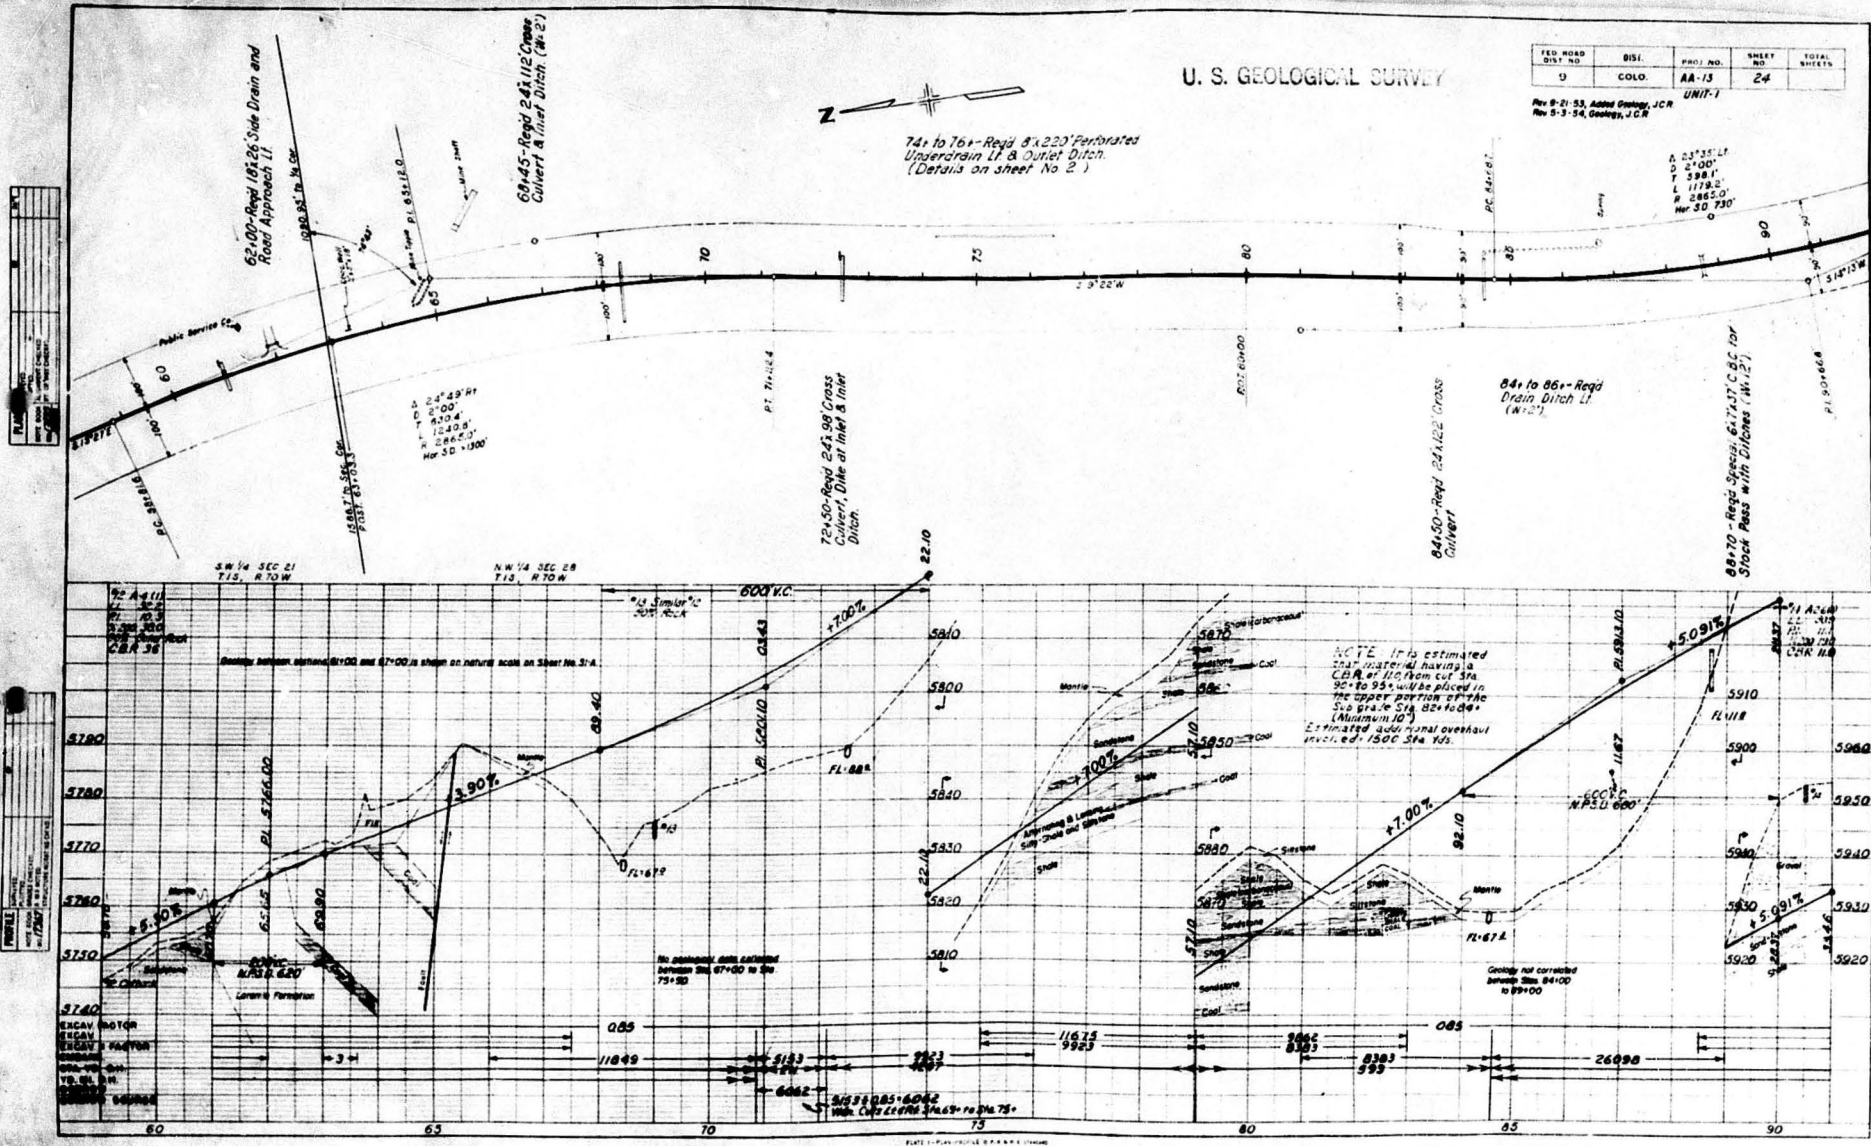




FED. ROAD DIST. NO.	DIST.	PROJ. NO.	SHEET NO.	TOTAL SHEETS


Rev. 8-21-53, Added Ecology. JCR

## U. S. GEOLOGICAL SURVEY

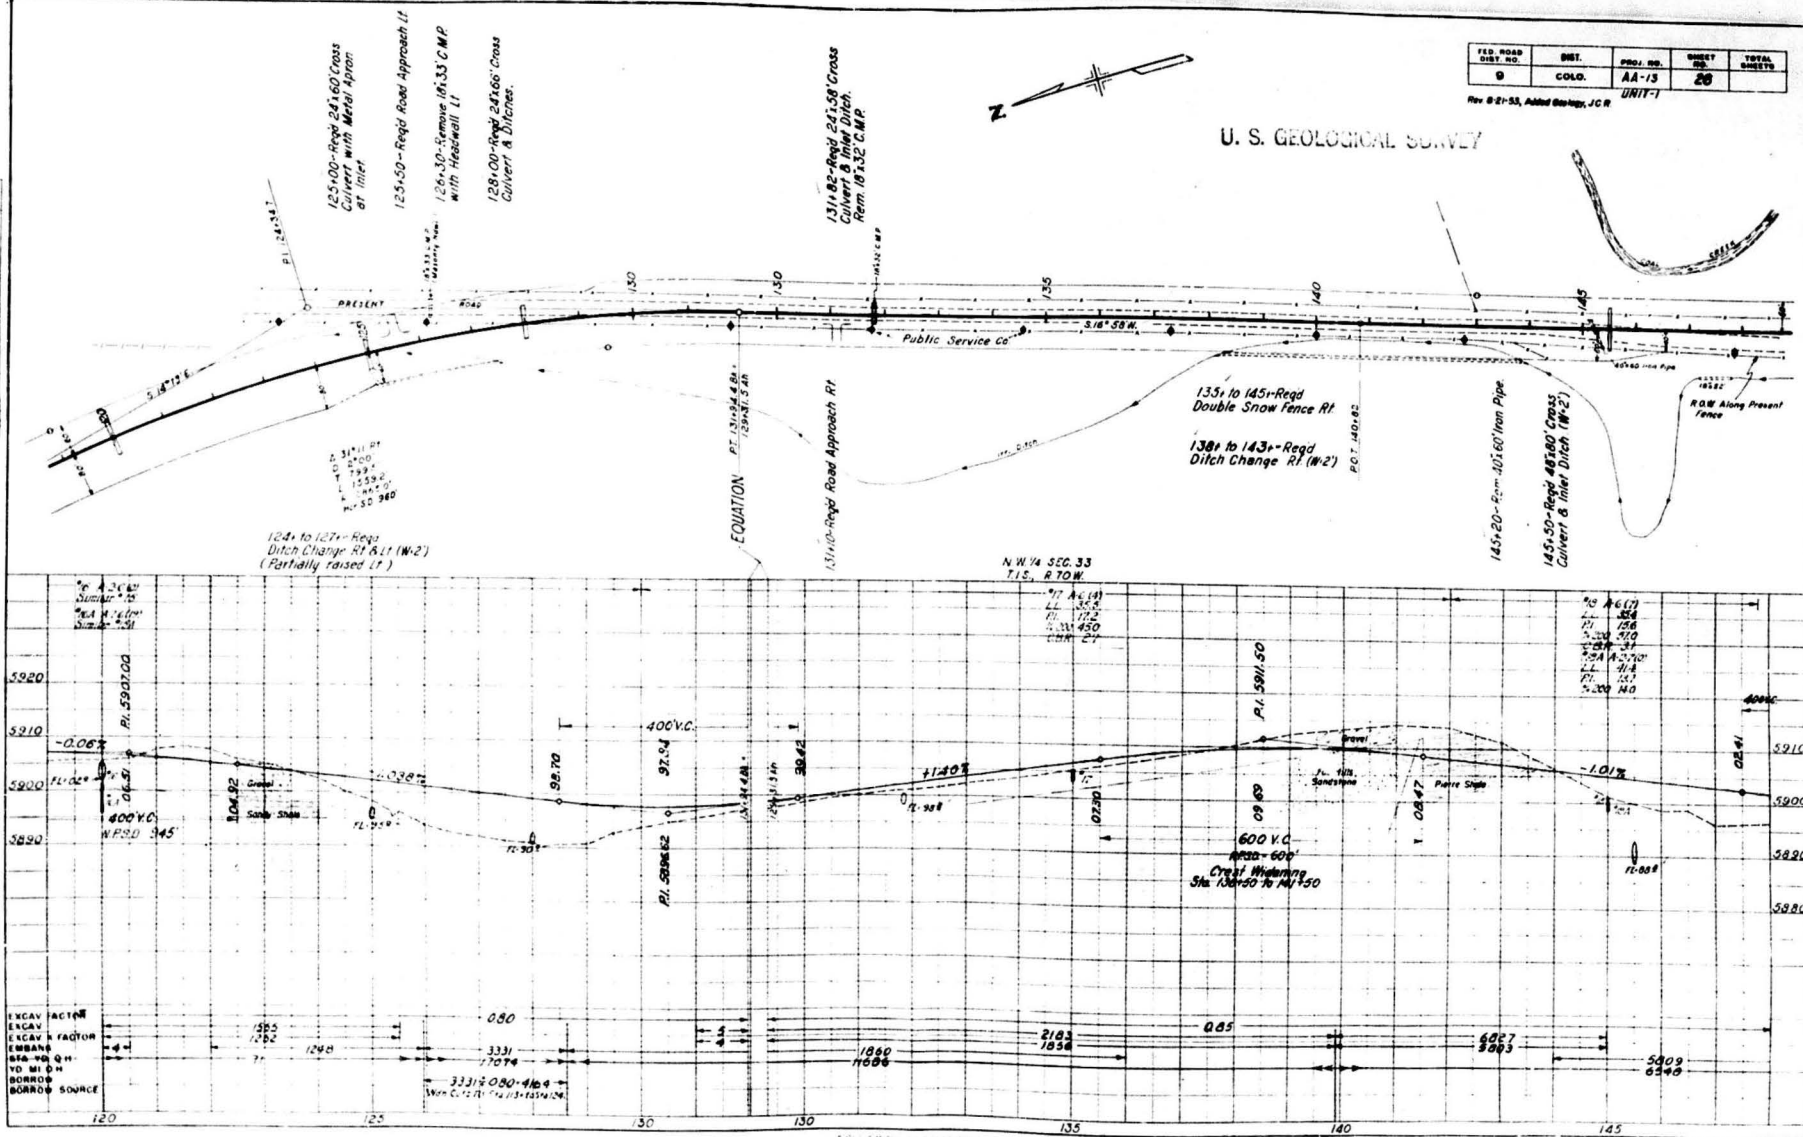


PLAN	DATE	BY	CHECKED
10/2/51	10/2/51	W. J. G. C.	W. J. G. C.

PROFILE	DATE	BY	CHECKED
10/2/51	10/2/51	W. J. G. C.	W. J. G. C.

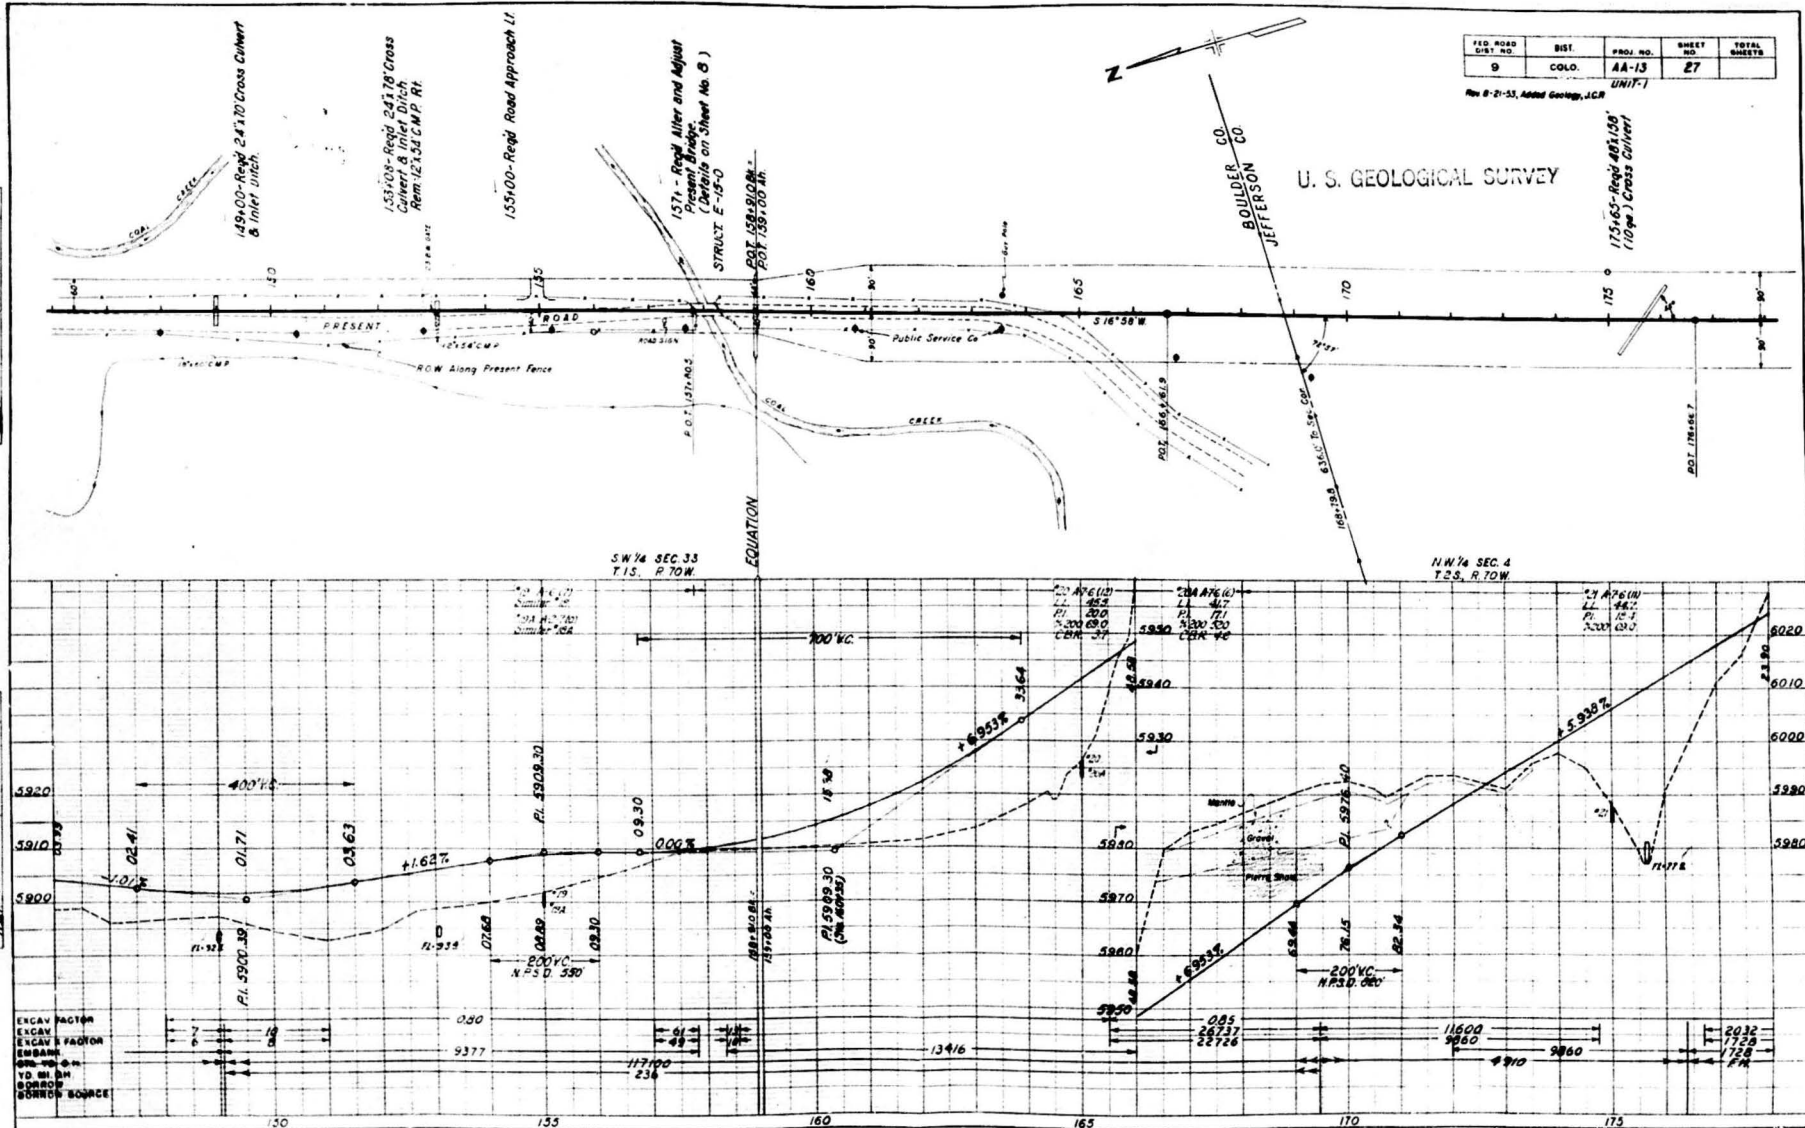




PLAN	DATE	BY	CHK

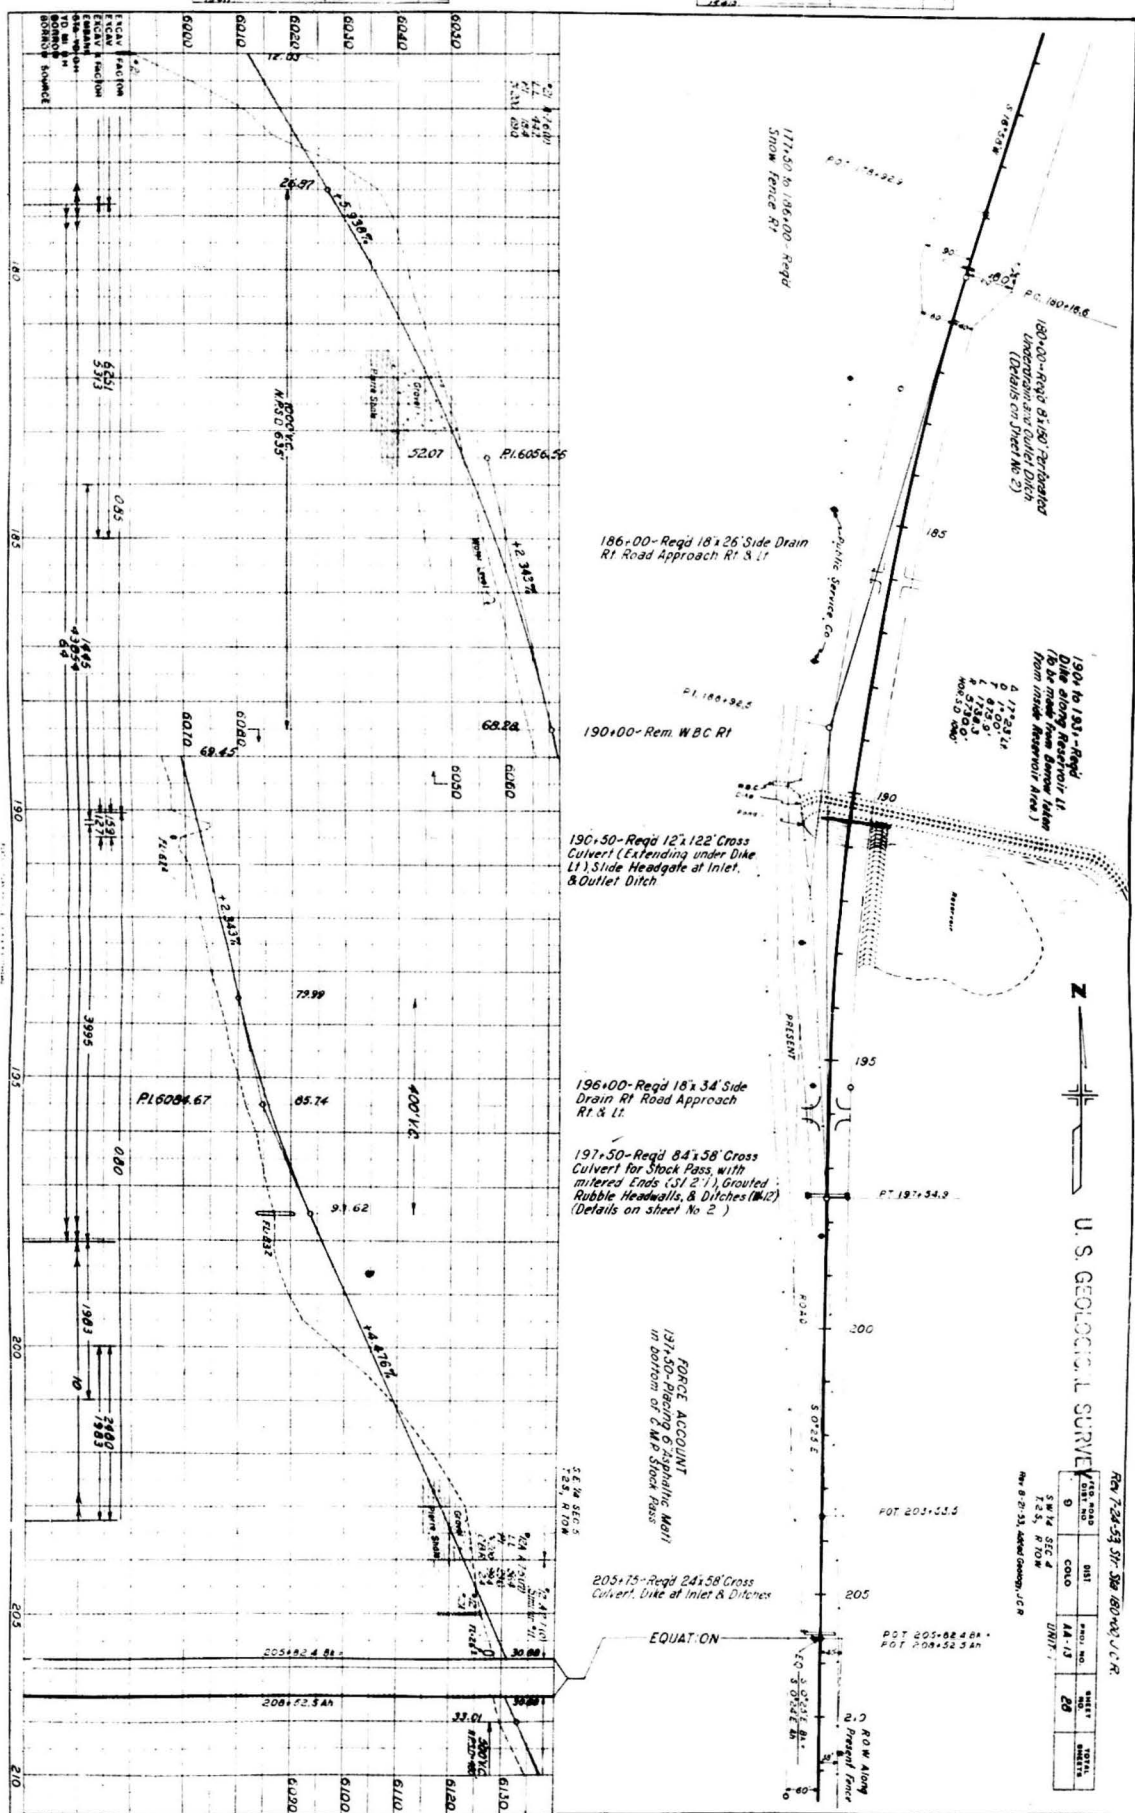

11451  
11452  
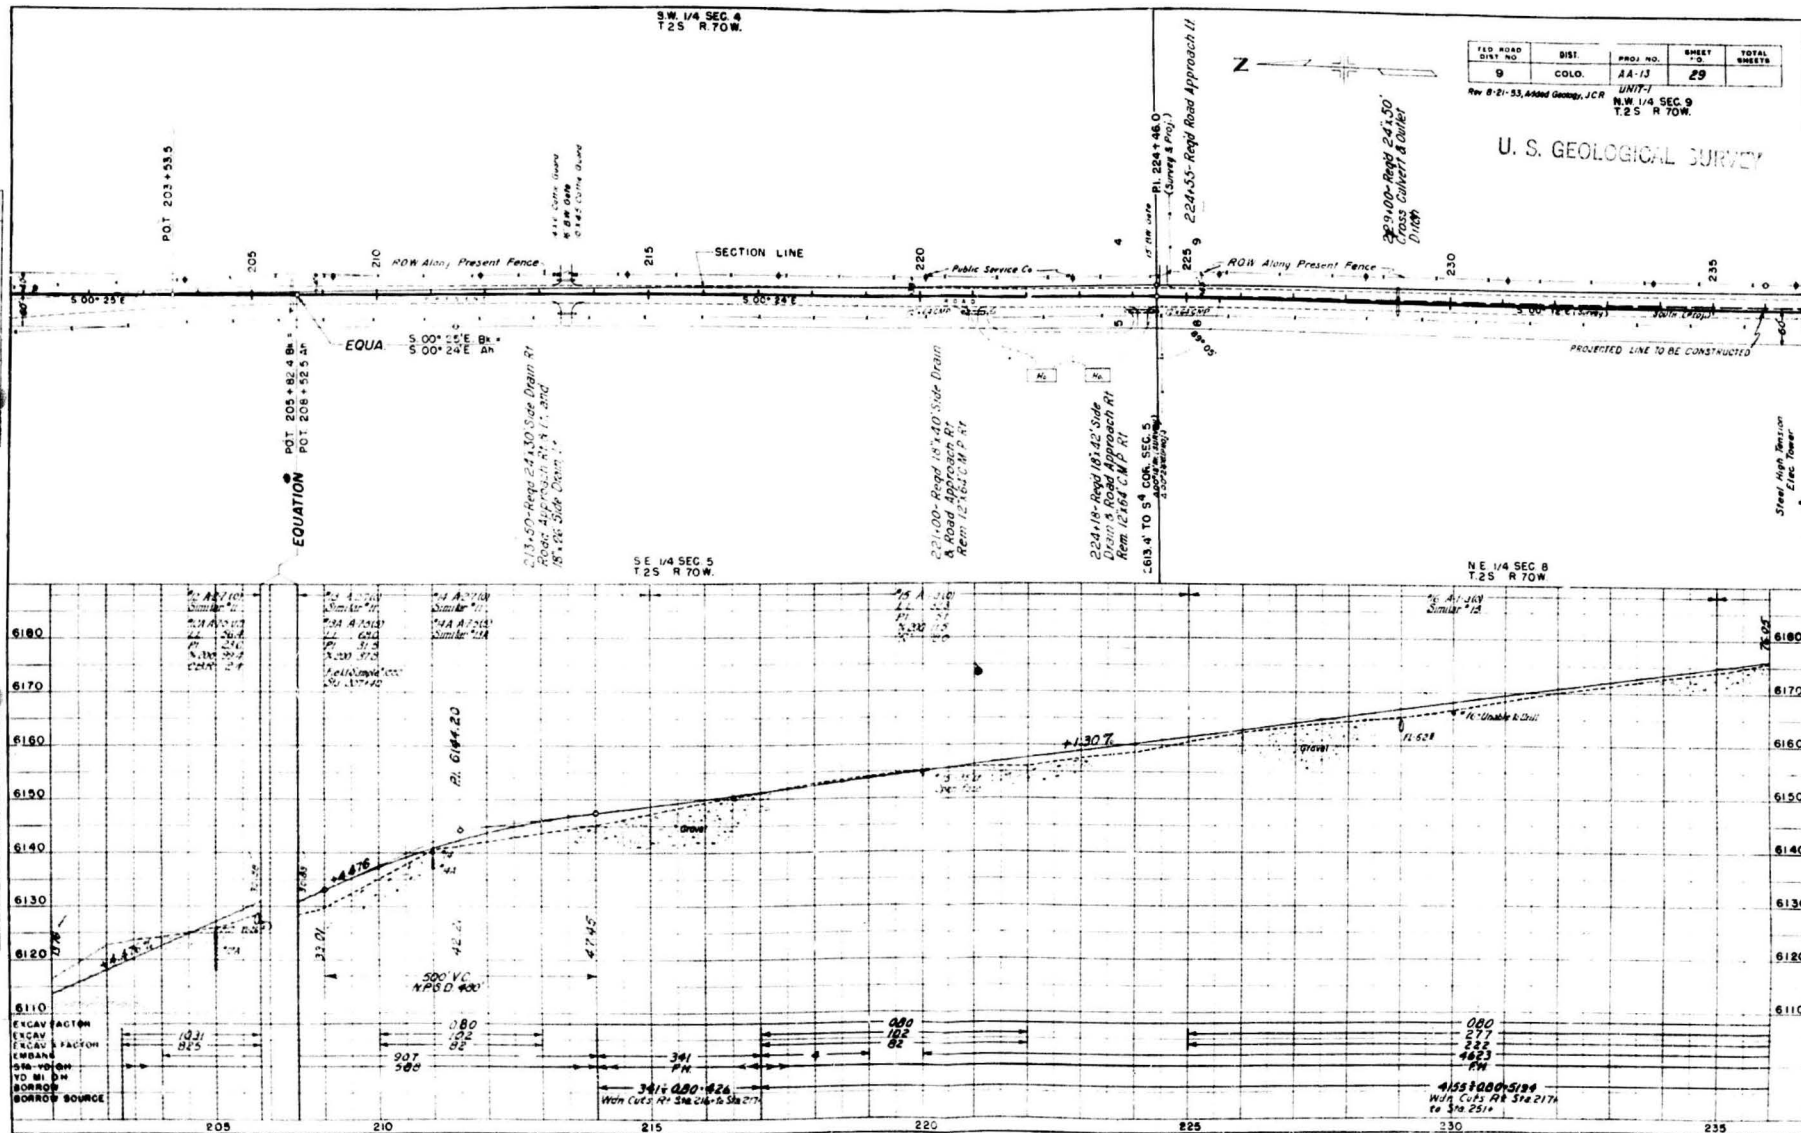[illegible]



S.W. 1/4 SEC. 9  
T.28. N.70W.





N.W. 1/4 SEC. 10  
T.28. N.70W.

U. S. GEOLOGICAL SURVEY




S.E. 1/4 SEC. 9  
T.28. N.70W.

STA 27+00-END UNIT 1  
SEC. UNIT 2 ON S.W. 33

2593.7 TO 26.000 SEC. 9  
P.L. 279+41.9  
(Curved 100 ft)

N.E. 1/4 SEC. 17  
T.28. N.70W.

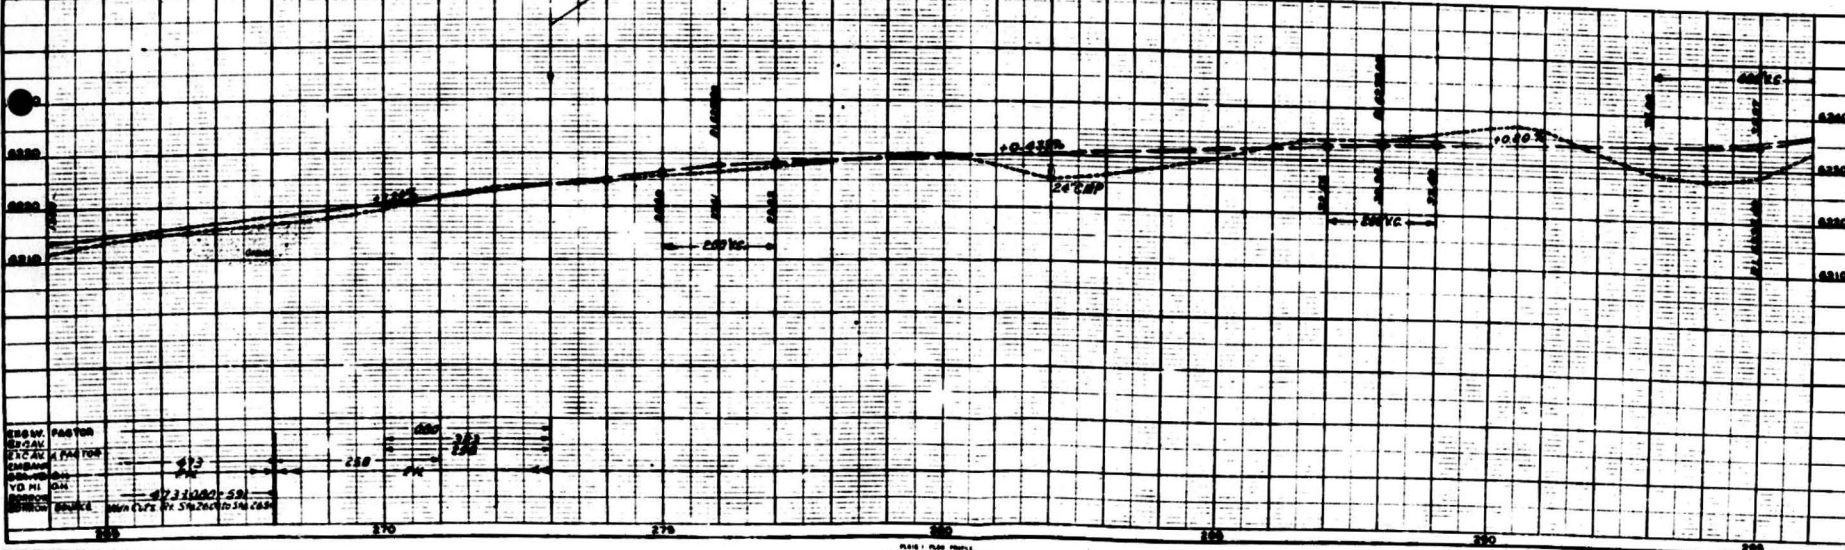

REMARKS: PAVT OR  
ST. 27+00 PAVT OR  

PLS 1 - PLAN PROFILE


PER ROAD MILE	DISTRICT	PROJ. NO.	SHEET NO.	TOTAL SHEETS
9	COLD	AA-18 UNIT I	516	

Added Sheet 8-21-53, J.C.R.  
Rev. 5-3-54, Geology, J.C.R.

U. S. GEOLOGICAL SURVEY

# Geologic Profile between Stations 61+00 and 67+00

Horizontal and Vertical scales 1 inch = 20 feet

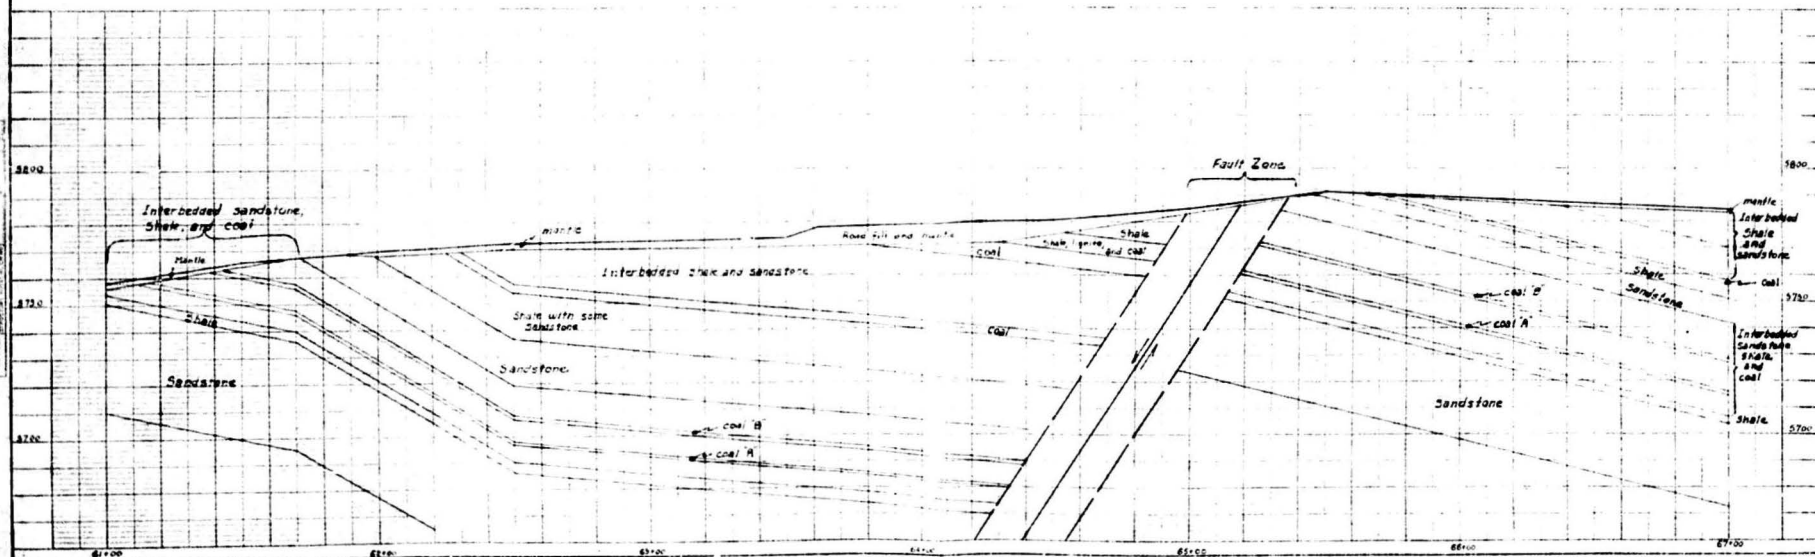




Embankment Area      Excavation Area      Embankment Area  
 Co. Yds. Area      Co. Yds. Area      Co. Yds. Area

FED. ROAD DIVISION NO.	DISTRICT	PROJ. NO.	SHEET NO.	TOTAL SHEETS




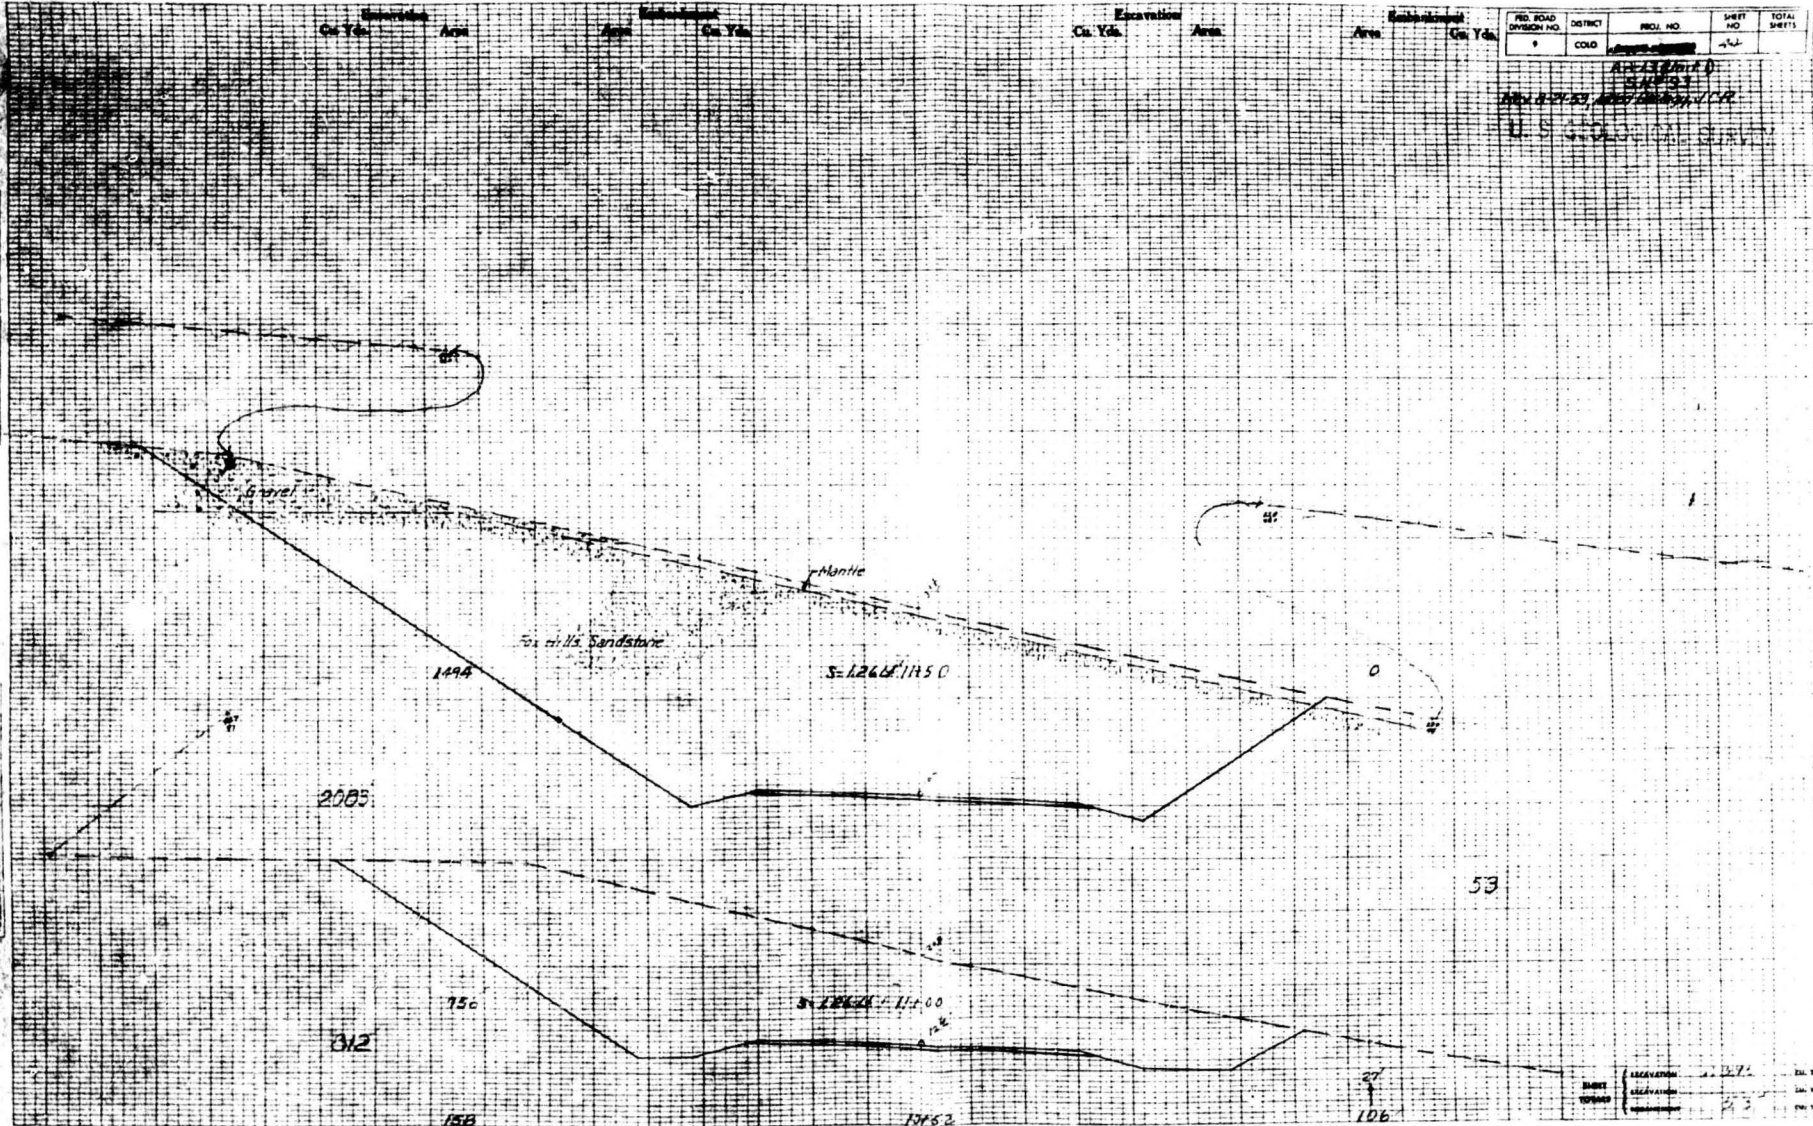






Excavation Area


Excavation Area

Excavation Area

Excavation Area

FED. ROAD DIVISION NO.	DISTRICT	PROJECT NO.	SHEET NO.	TOTAL SHEETS
9	100	100-13 (Unit 1)	25	

REV. 5-25-53, Added Gravelly L.R.

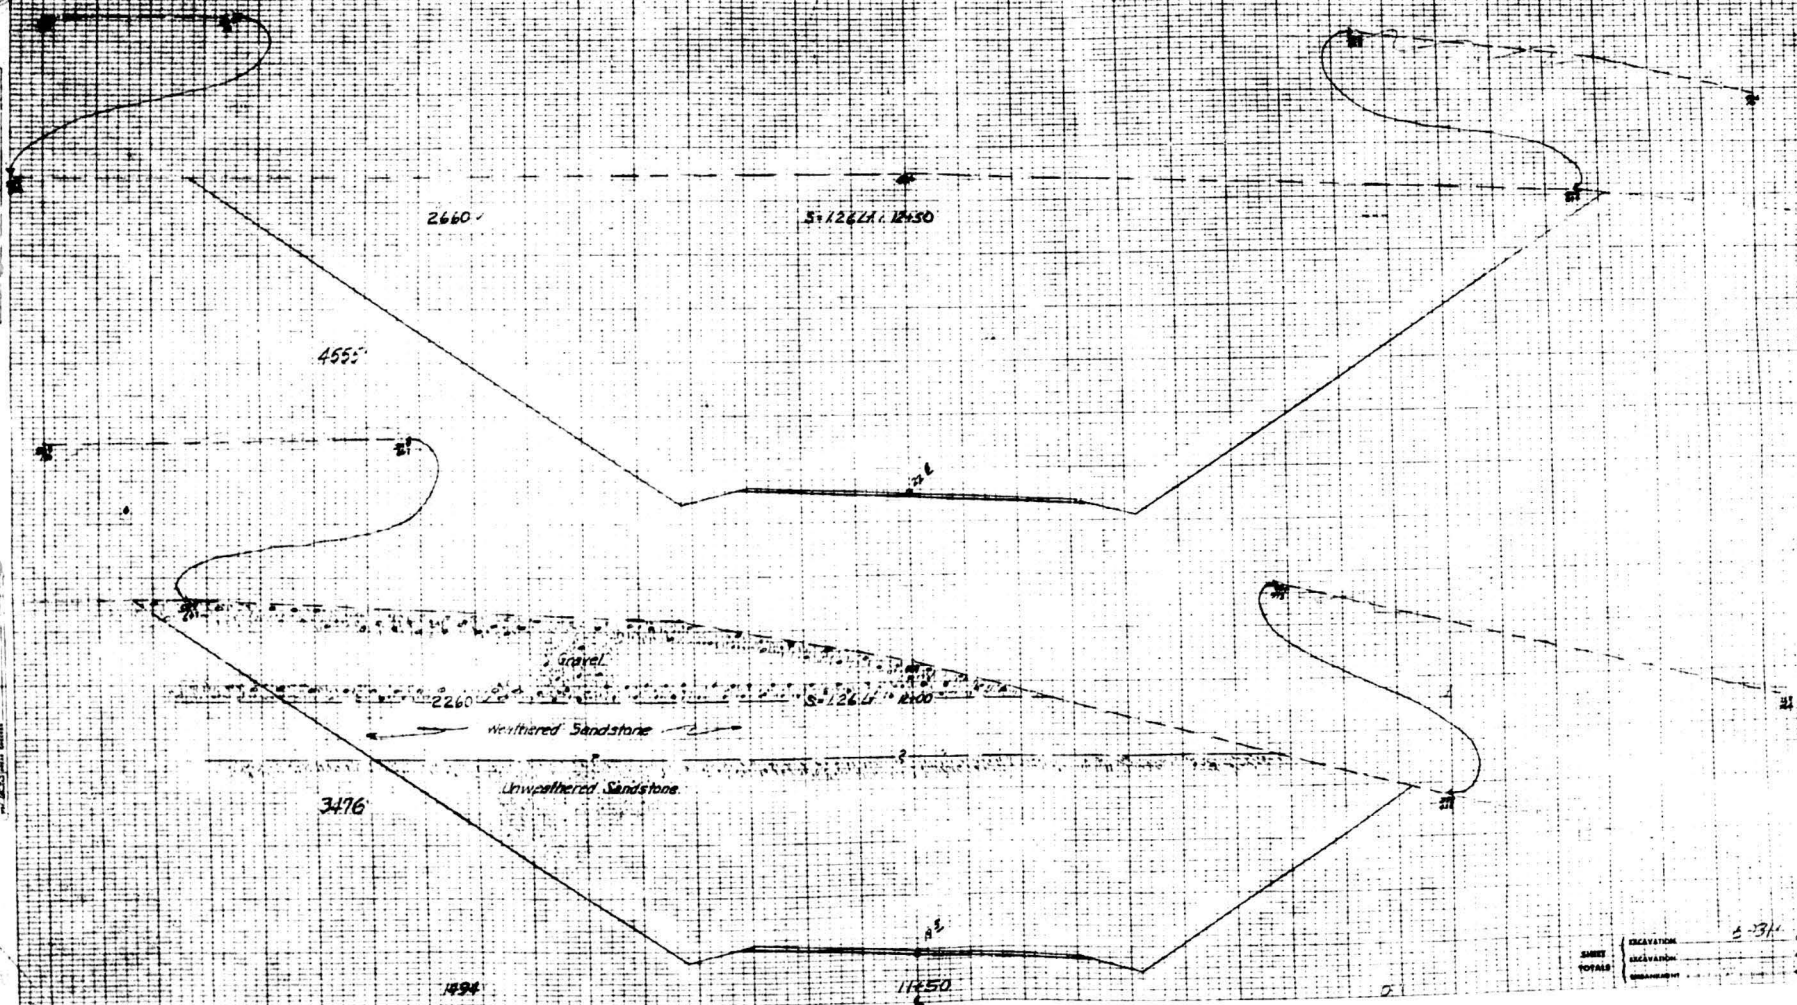

SHEET TOTALS	EXCAVATION	EXCAVATION	EXCAVATION

5-31

Excavation  
Cu. Yds. Area


Excavation  
Cu. Yds. Area

Excavation  
Cu. Yds. Area

Excavation  
Cu. Yds. Area

PROJECT NO.	SHEET NO.	TOTAL SHEETS
13071	10	

5/11/33  
Hwy 2-2155, Area 1, Section 1, T.18.  
U.S. GEOLOGICAL SURVEY

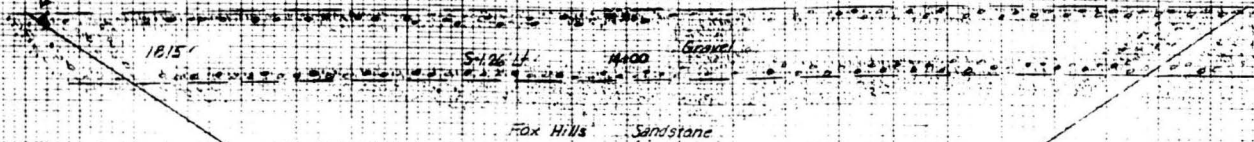

7399'

Fox Hills Sandstone

2455'

5-126.1'

13071

4736'

2660'

12450

EXCAVATION	Cu. Yds.
13071	
TOTALS	
13071	



Excavation  
Cu. Yds. Area

Embankment  
Area Cu. Yds.

Excavation  
Cu. Yds. Area

Embankment  
Area Cu. Yds.

STATE ROAD DIVISION NO.	DISTRICT	PROJECT NO.	SHEET NO.	TOTAL SHEETS
9	610	AA-13(Unit 1)	47	


AA-13(Unit 1)  
SH#93

REVISED DATA SHEET 100  
REV. 5-3-64 GEOL. SURV. 100

U. S. GEOLOGICAL SURVEY



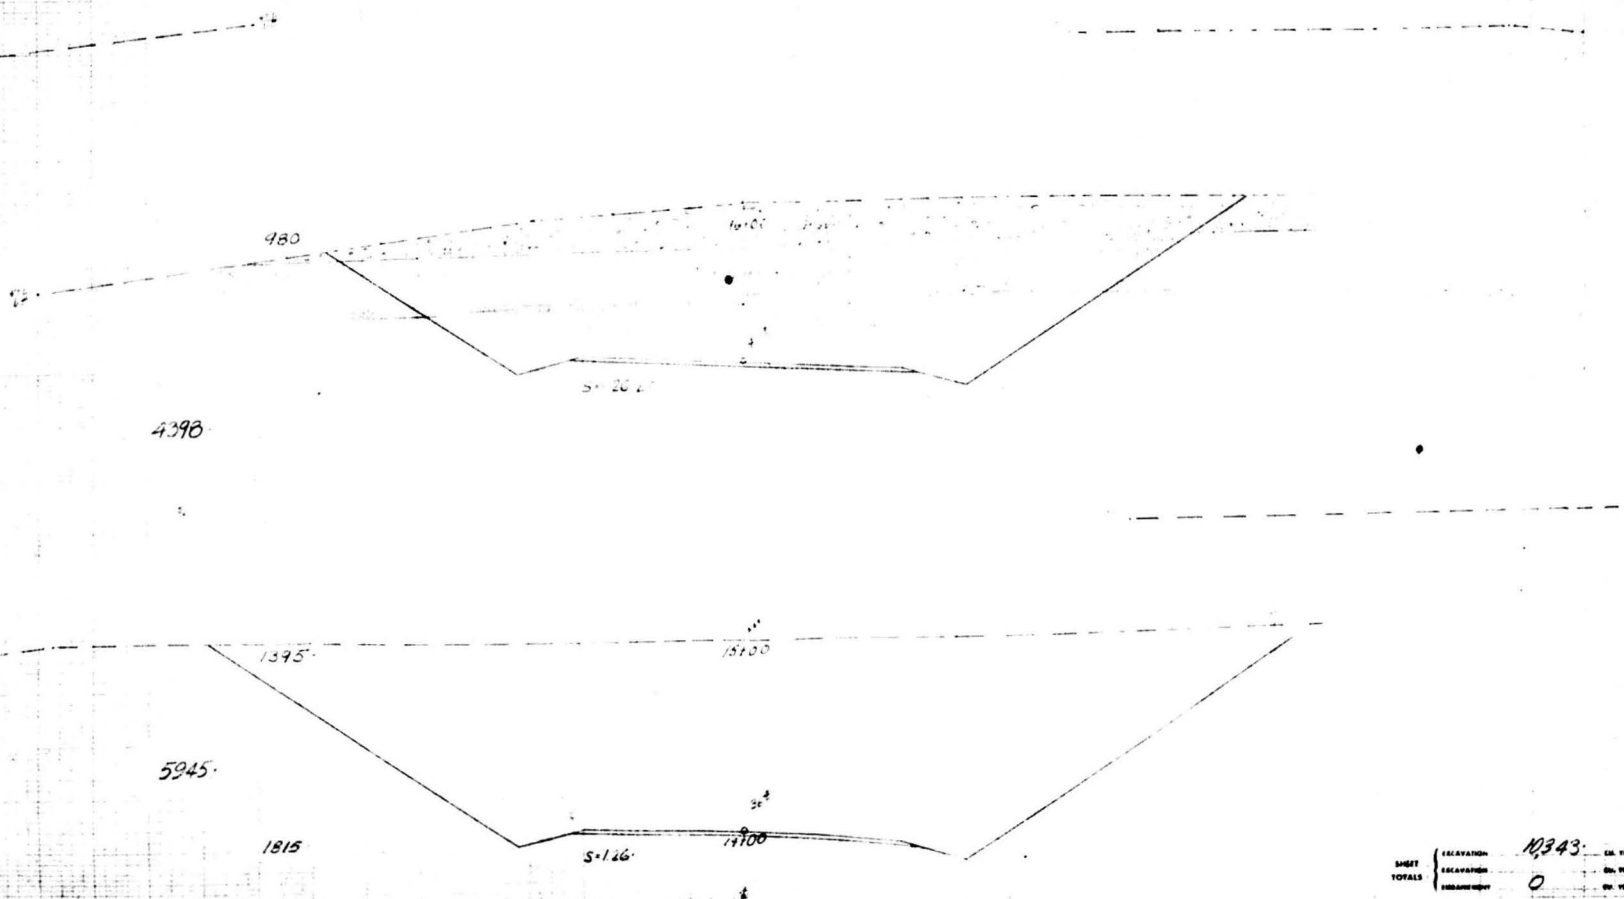

SHEET TOTALS	EXCAVATION	10343	CU. YDS.
	EMBANKMENT	0	CU. YDS.
	TOTALS		

Ca. Yds. Area

Ca. Yds. Area


Ca. Yds. Area

FED. ROAD DIVISION NO.	DISTRICT	PROJ. NO.	SHEET NO.	TOTAL SHEETS
9	COLO.	AA-13 (Unit 1)	4B	

SN 193  
Rev. 5-21-55, Added Geology, J.C.R.  
Rev. 5-3-56, Geology, J.C.R.

U. S. GEOLOGICAL SURVEY

23.5  
0.5

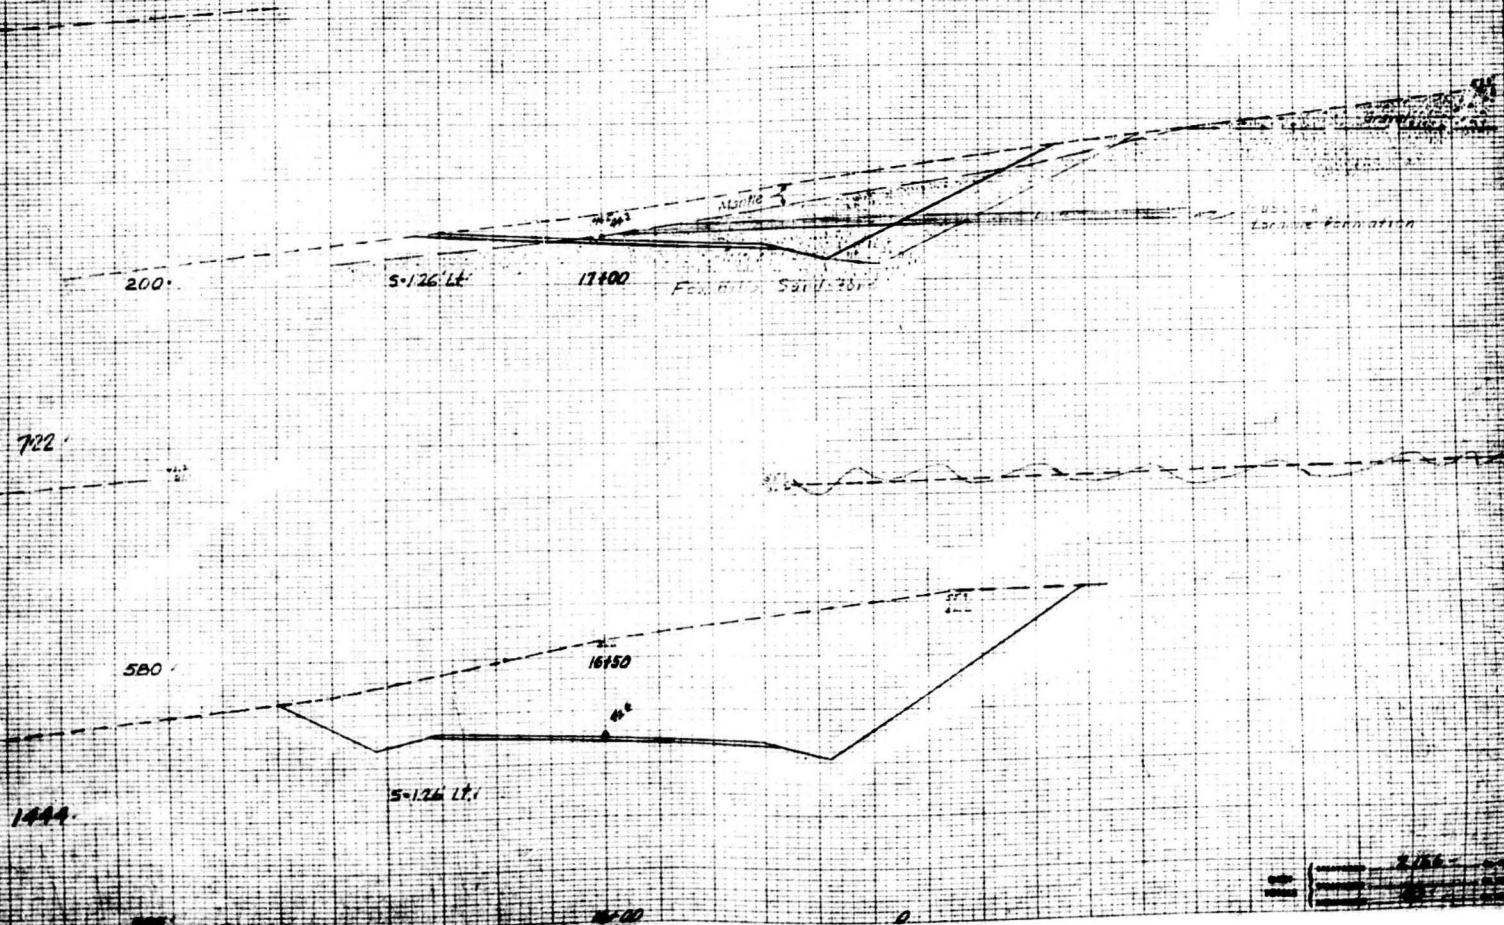


Scale	1" = 100'
North Arrow	

1	2	
---	---	---	---	---	---	---	---	---	----	----	-----

1	2	
---	---	---	---	---	---	---	---	---	----	----	-----

U.S. ROAD DISTRICT NO.	DISTRICT	PROJ. NO.	SHEET NO.	TOTAL SHEETS
9	COLO.	A-13 (2011)	29	

U.S. GEOLOGICAL SURVEY

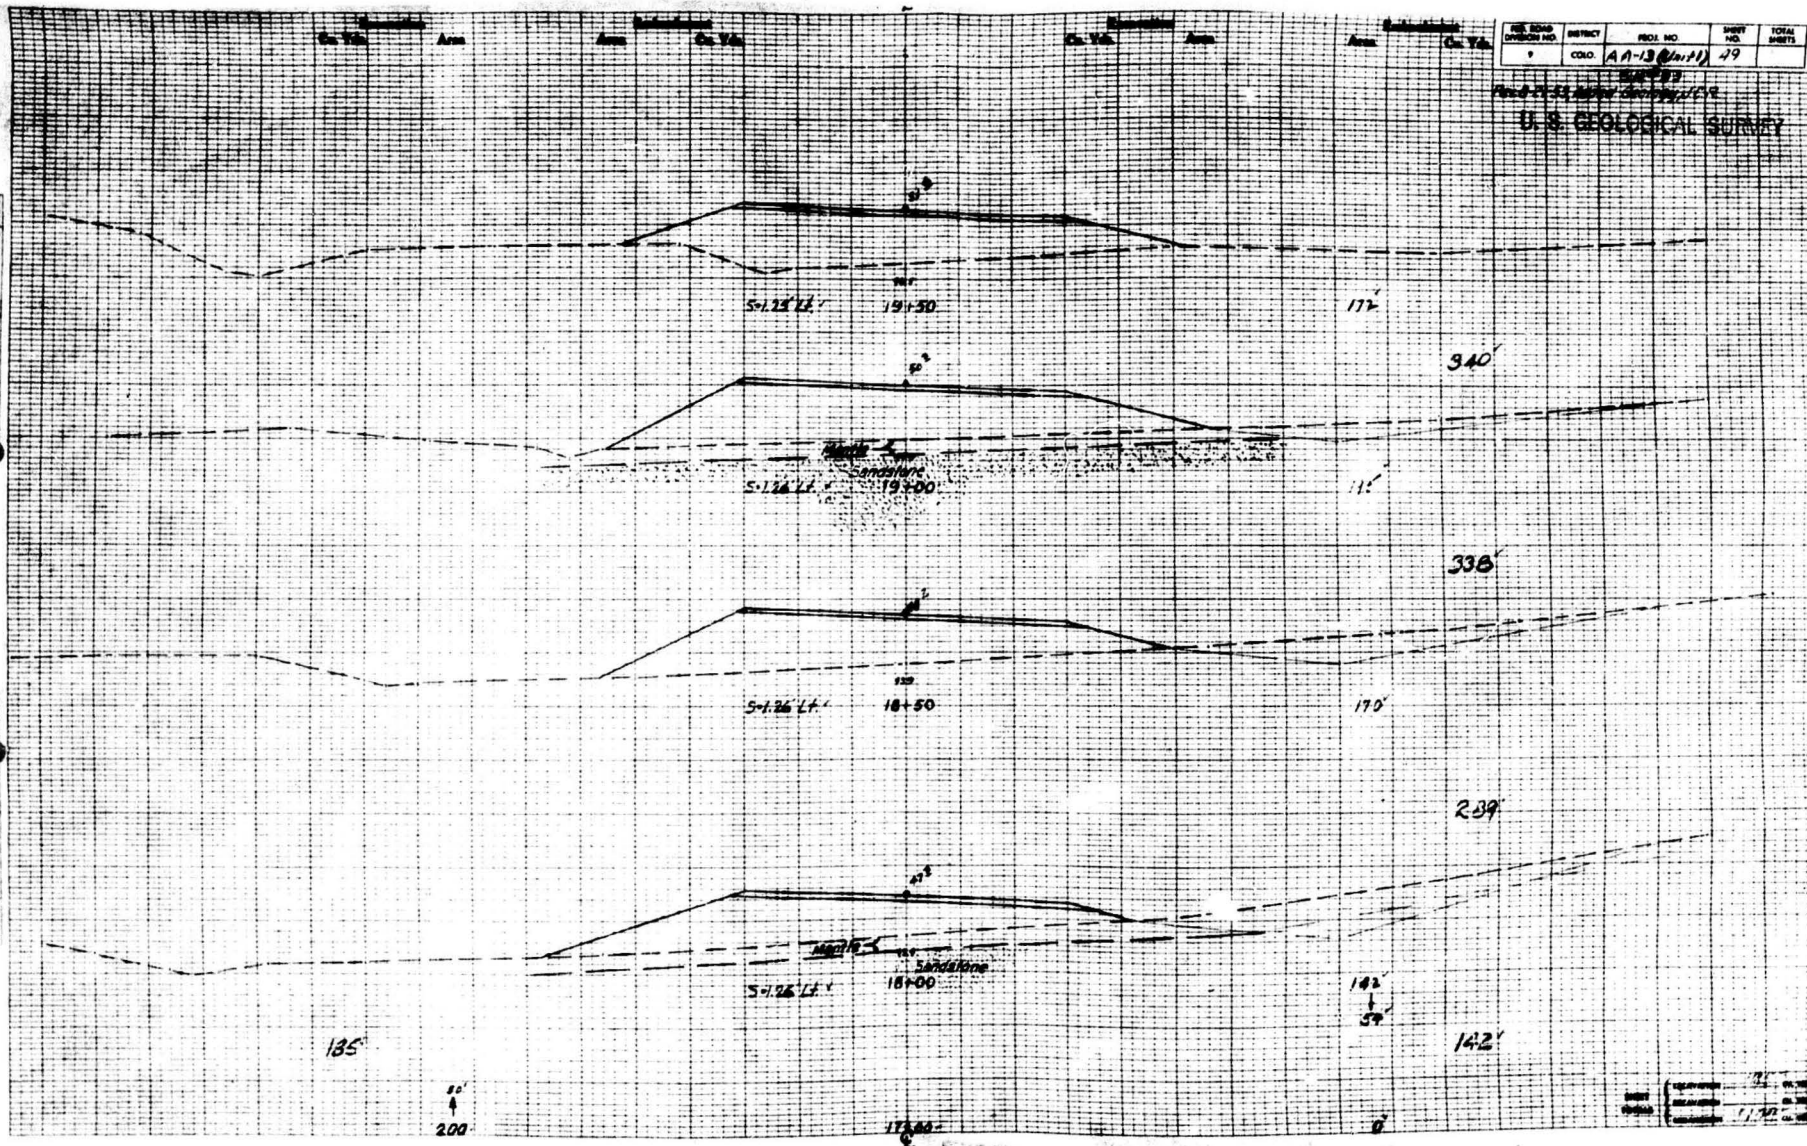

1	2	
---	---	---	---	---	---	---	---	---	----	----	-----

Excavation	
Cu. Yds.	Area

Area	Embankment	Cu. Yds.
1		
2		
Excavation	
Cu. Yds.	Area


Area	Embankment	Cu, Yds
------	------------	---------


SH-93


U. S. GEOLOGICAL SURVEY

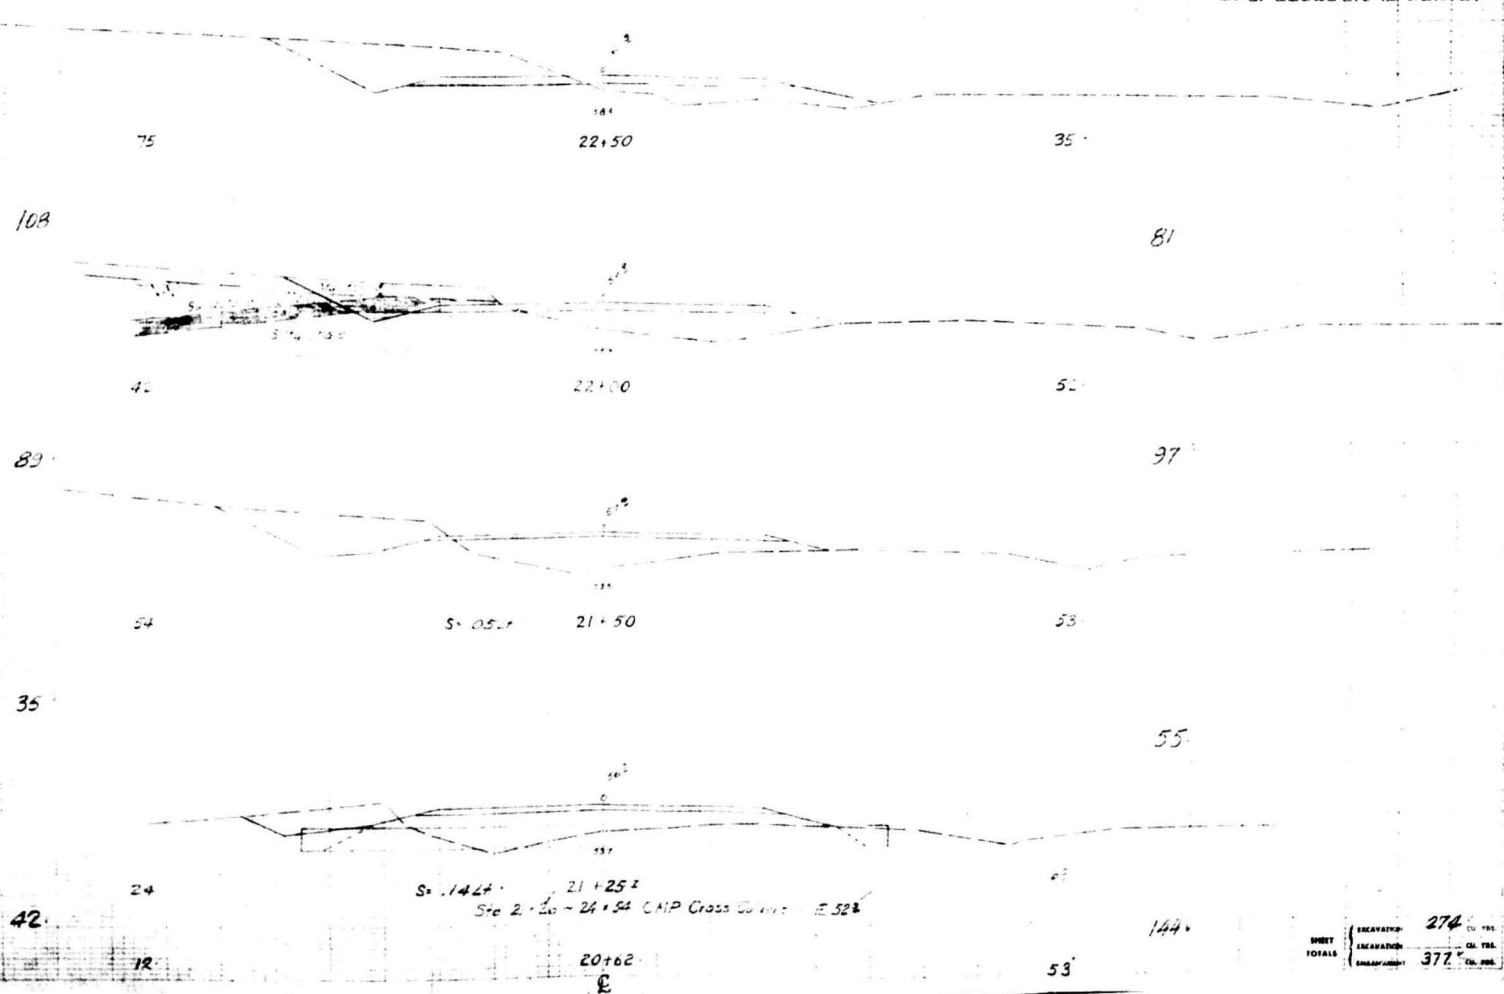


Sta 2: 20 ~ 24 = 54 CNP Cross Section = 52%



RED ROAD DISTRICT NO.	DISTRICT	PROJECT NO.	SHEET NO.	TOTAL SHEETS
9	COLD	AA-13 (Univ-1)	3493	

For D-2-13, 1/2" x 1/2" 200,000/1" A

U. S. GEOLOGICAL SURVEY

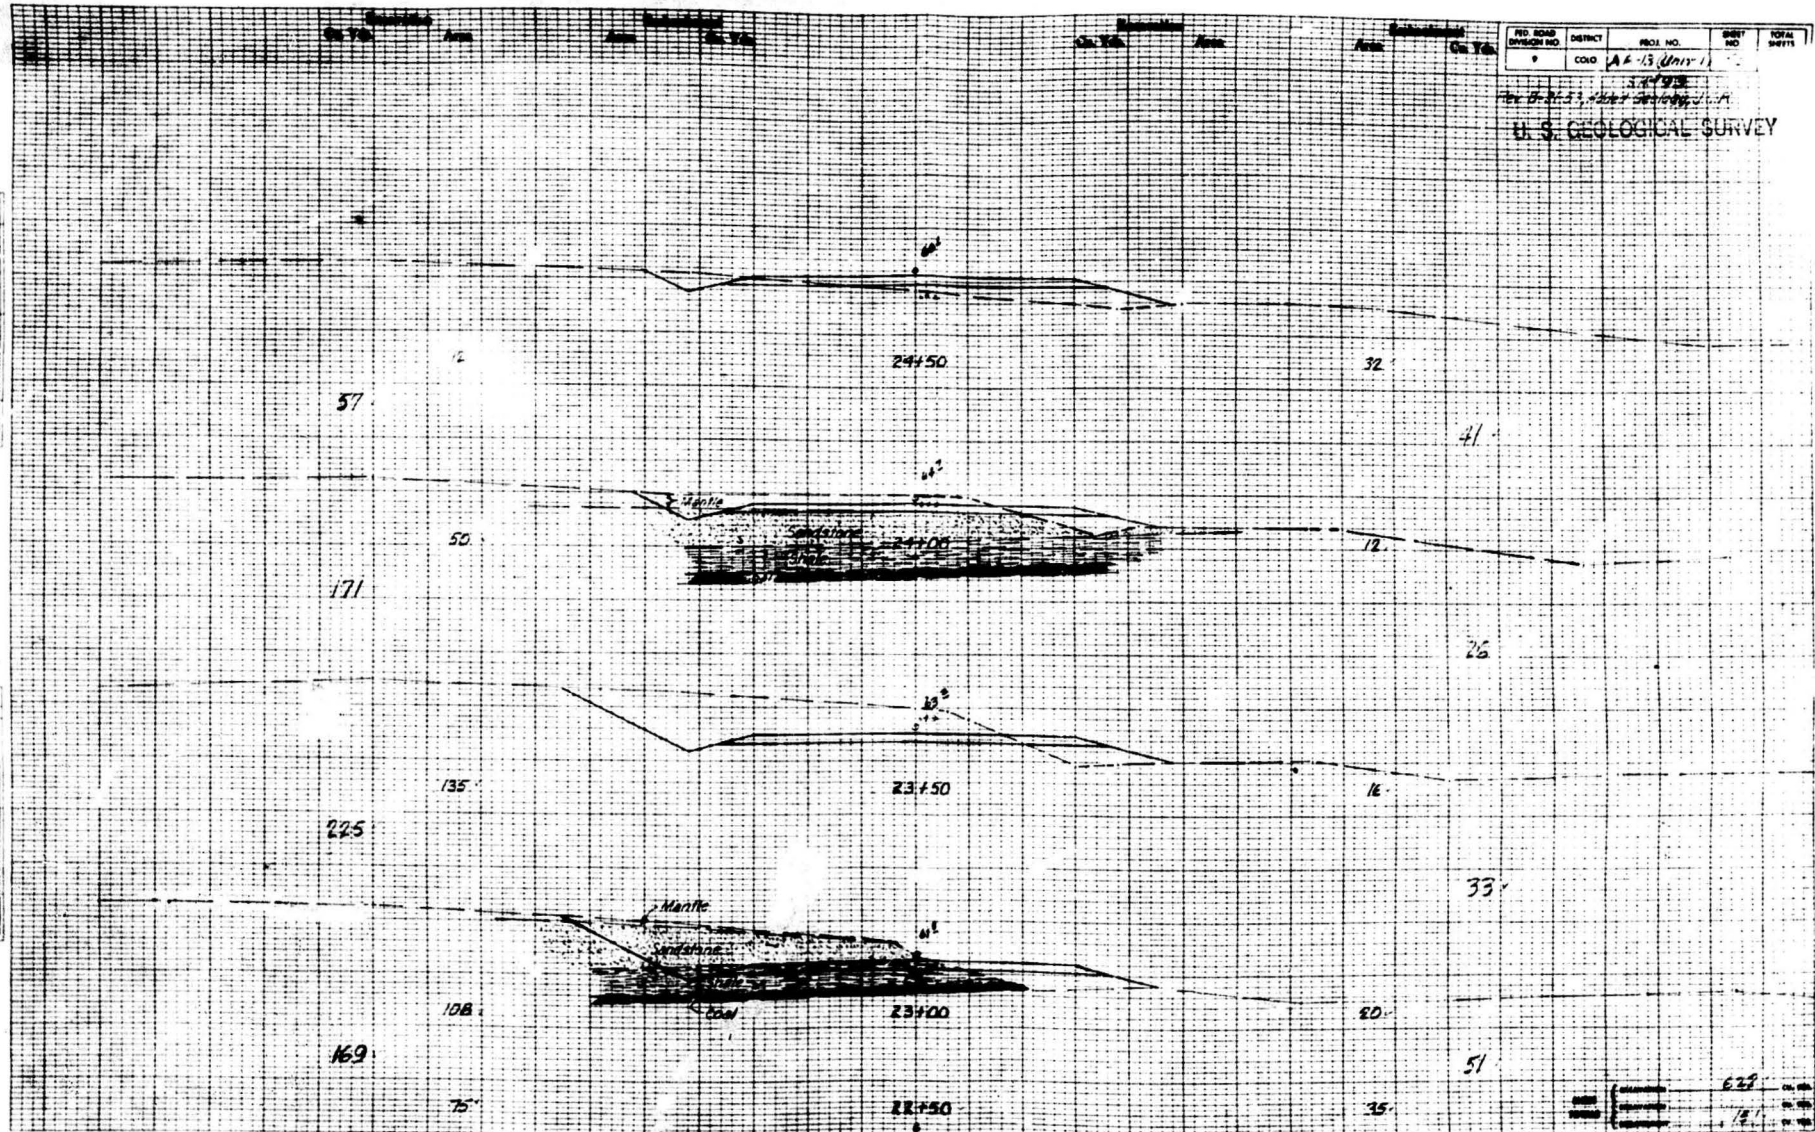

628	CH. 100
1/2	CH. 100

Restoration  
Co. Yds. Area

Restoration  
Co. Yds. Area

Restoration  
Co. Yds. Area

Restoration  
Co. Yds. Area

FED. ROAD DIVISION NO.	DISTRICT	PROJ. NO.	SHEET NO.	TOTAL SHEETS
9	COLO.	AA-13 (Unit 1)	53	

5/14/53  
Rev. D. N. S. Mining Geology, L.P.

U.S. GEOLOGICAL SURVEY

65

27+00

3

95

Mantle

27

18

26+50

26

19

78

2

26+00

58

5

116

3

25+50

63

7

109

15

4

25+00

55

81

24+50

57

DATE	BY	CHKD.	APPD.
5/14/53			



Ch. Yds. Area Area Ch. Yds.

Ch. Yds. Area

Area Ch. Yds.

FED. ROAD DISTRICT	PROJECT NO.	SHEET NO.	TOTAL SHEETS
9	AA-30(11)	54	

Rev. 8-21-54 (Road Geometry, H.C.R.)

U. S. GEOLOGICAL SURVEY

85

99

28+50

0

54

28+25

0

107

146

28+00

248

110

27+50

0

190

85

27+00

Mantle

Sandstone

Shale

Fill


DATE	PREPARED BY	CHECKED BY	DATE

On Yds. Area      On Yds. Area      On Yds. Area      On Yds. Area  
 Excavation      Excavation      Excavation      Excavation

FED. ROAD DIVISION NO.	DISTRICT	PROJECT NO.	SHEET NO.	TOTAL SHEETS
9	COLO.	AA-13 (Unit 1)	53	

S. 17° 56' E.  
 Rwy. 22-23, A. 1000' S. 100' E. R.


U.S. GEOLOGICAL SURVEY

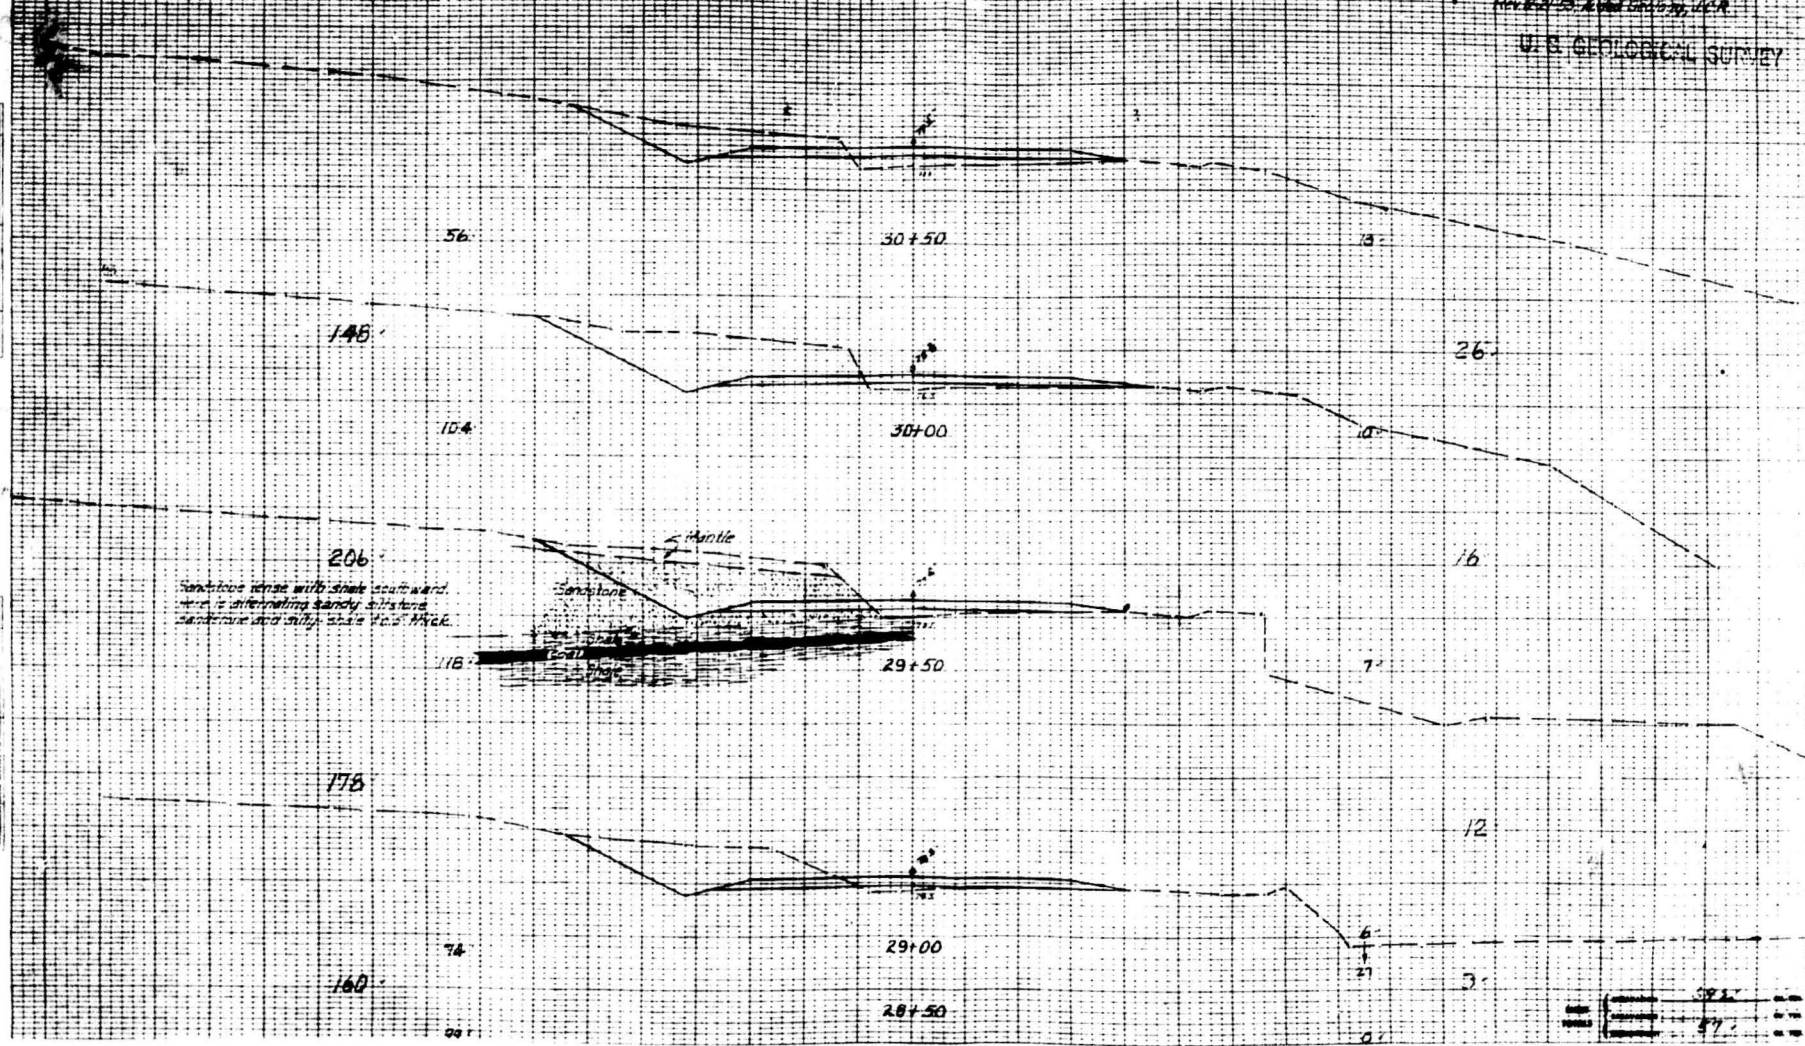





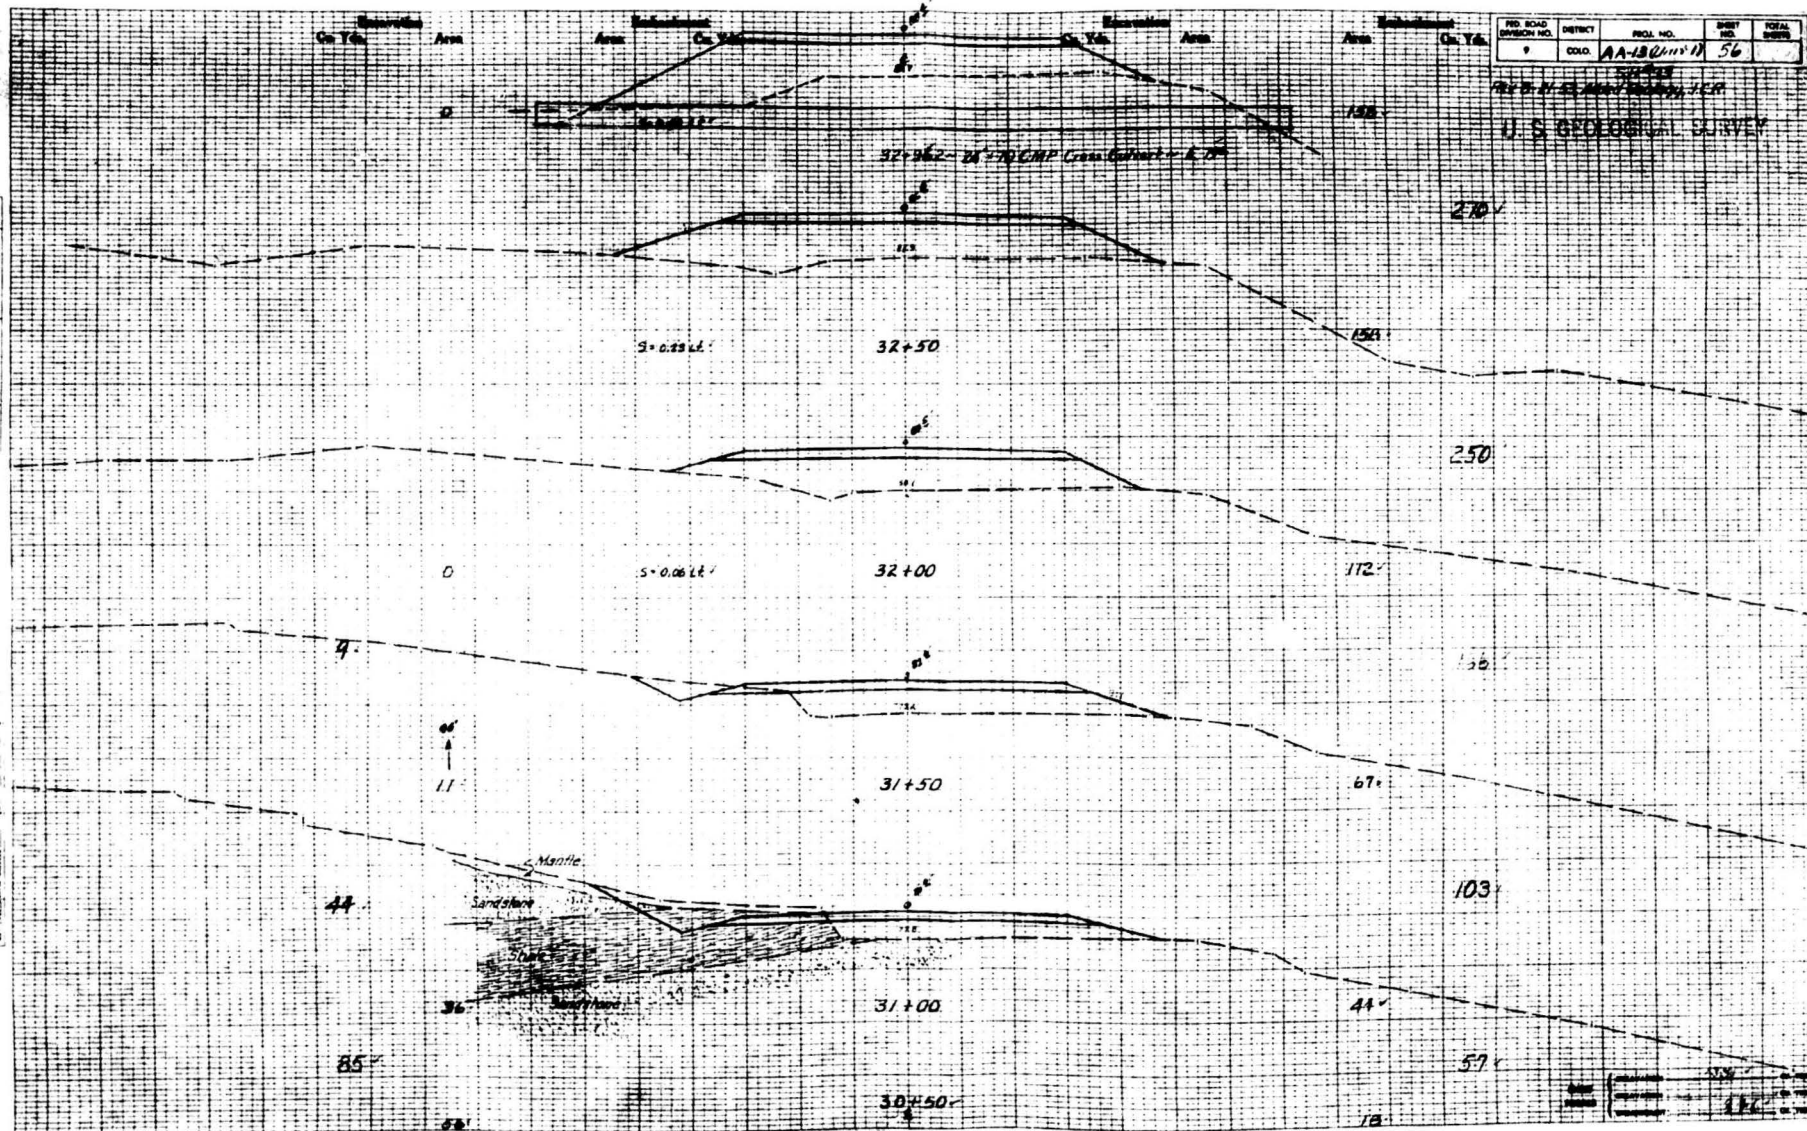

Embankment Area Cut Yds. Area Excavation Area Cut Yds. Area Embankment Area Cut Yds.


FED. ROAD DIVISION NO.	DISTRICT	PROJ. NO.	SHEET NO.	TOTAL SHEETS
9	COLO.	AA-13(2nd 11)	57	


U.S. GEOLOGICAL SURVEY




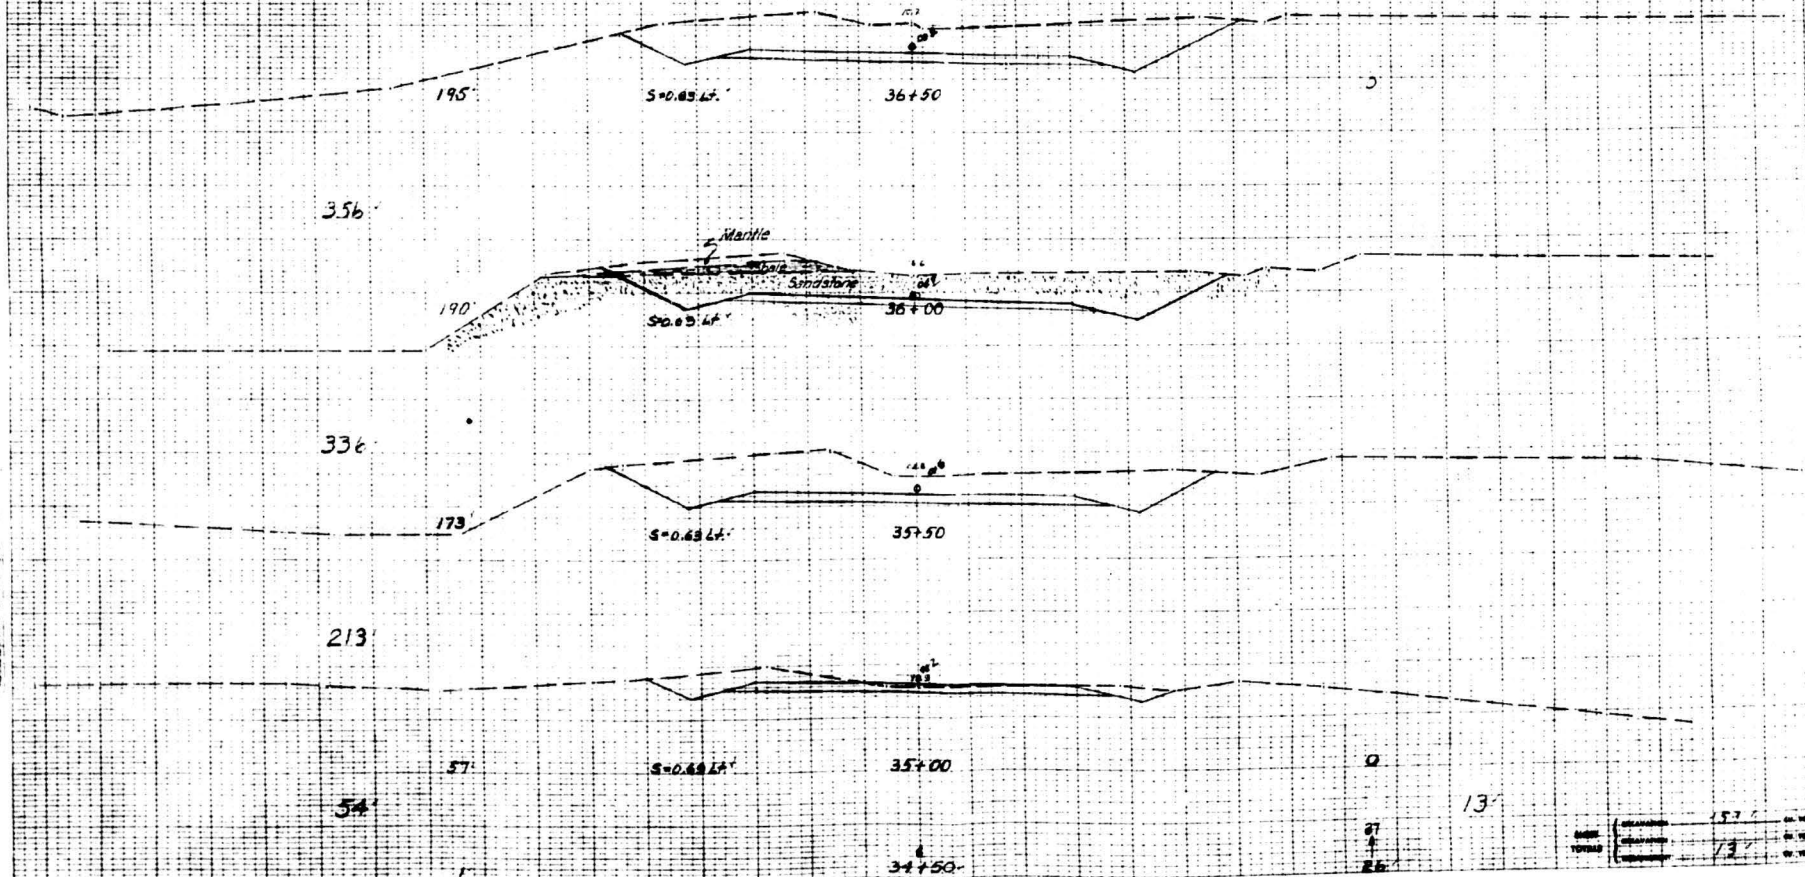


1  
 2  
1  
 2  
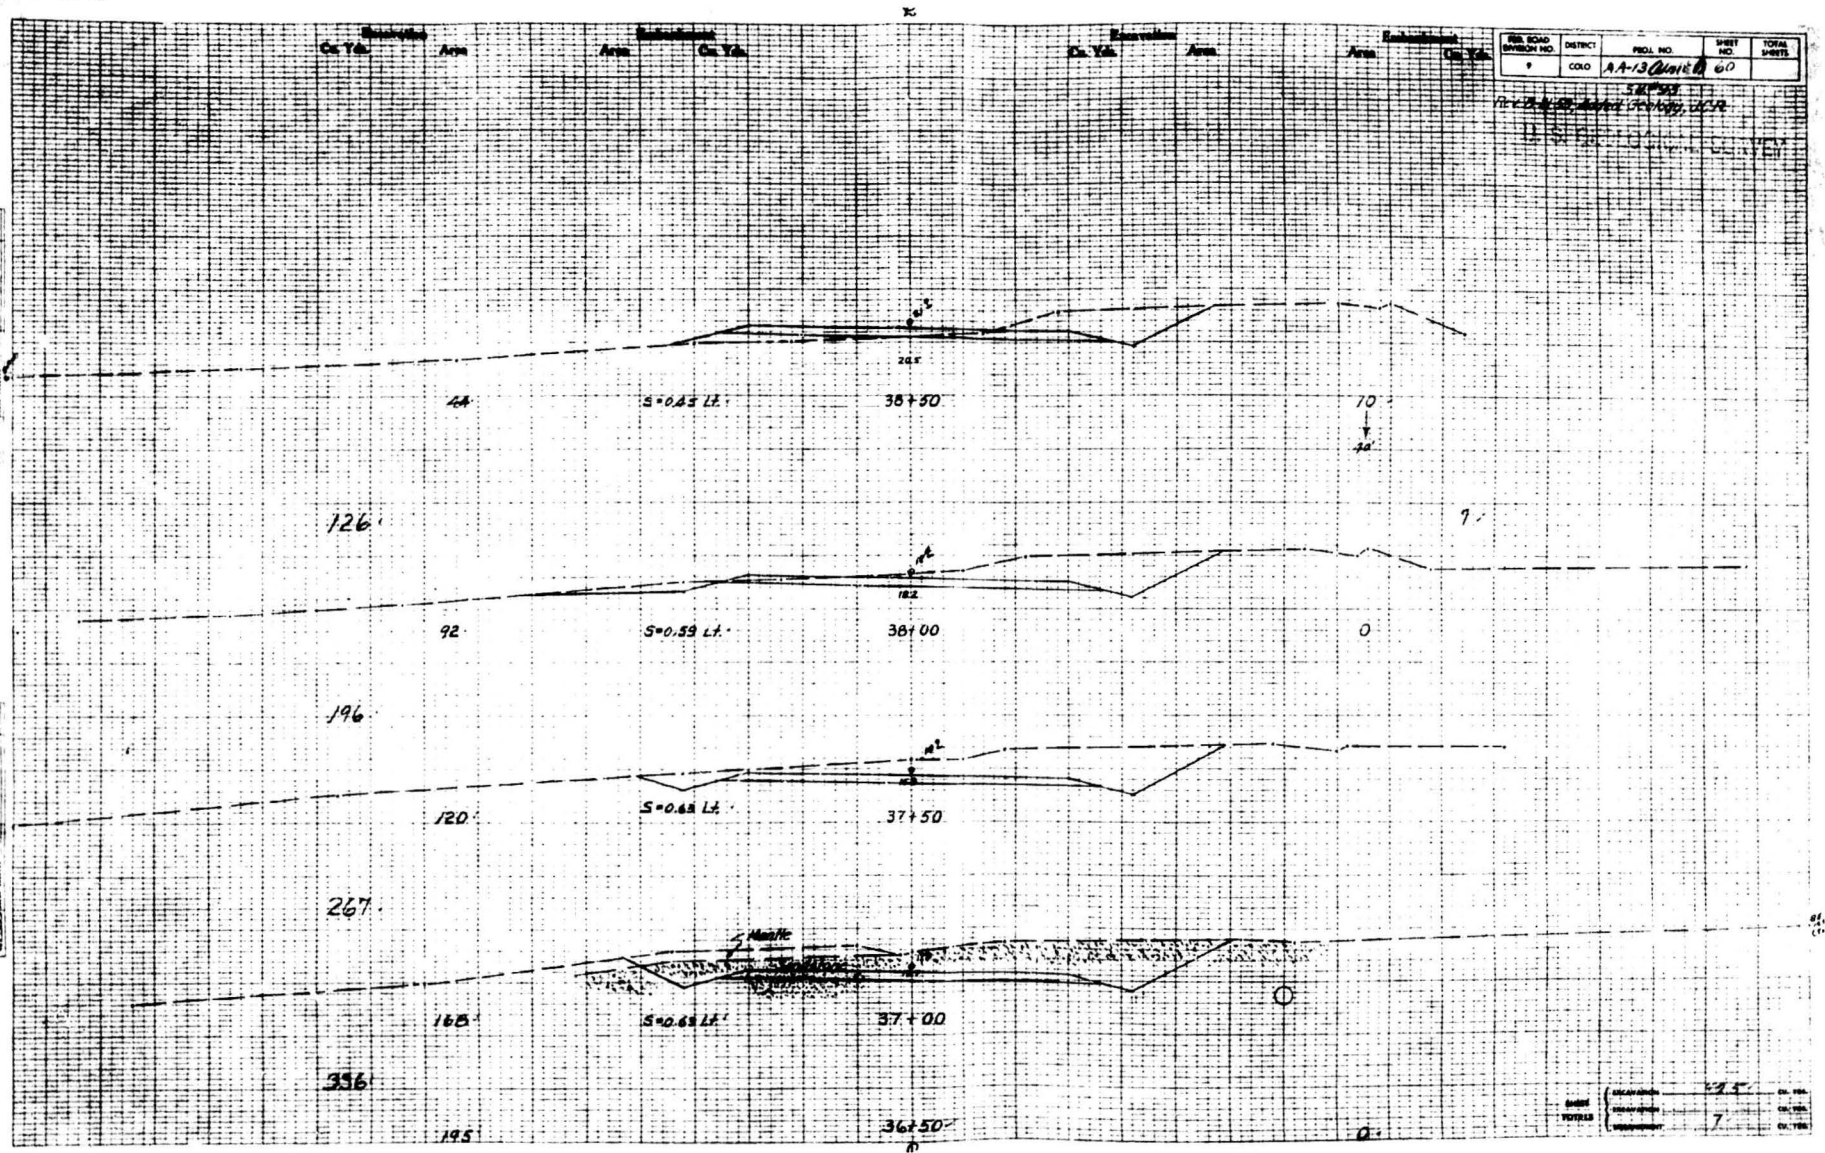



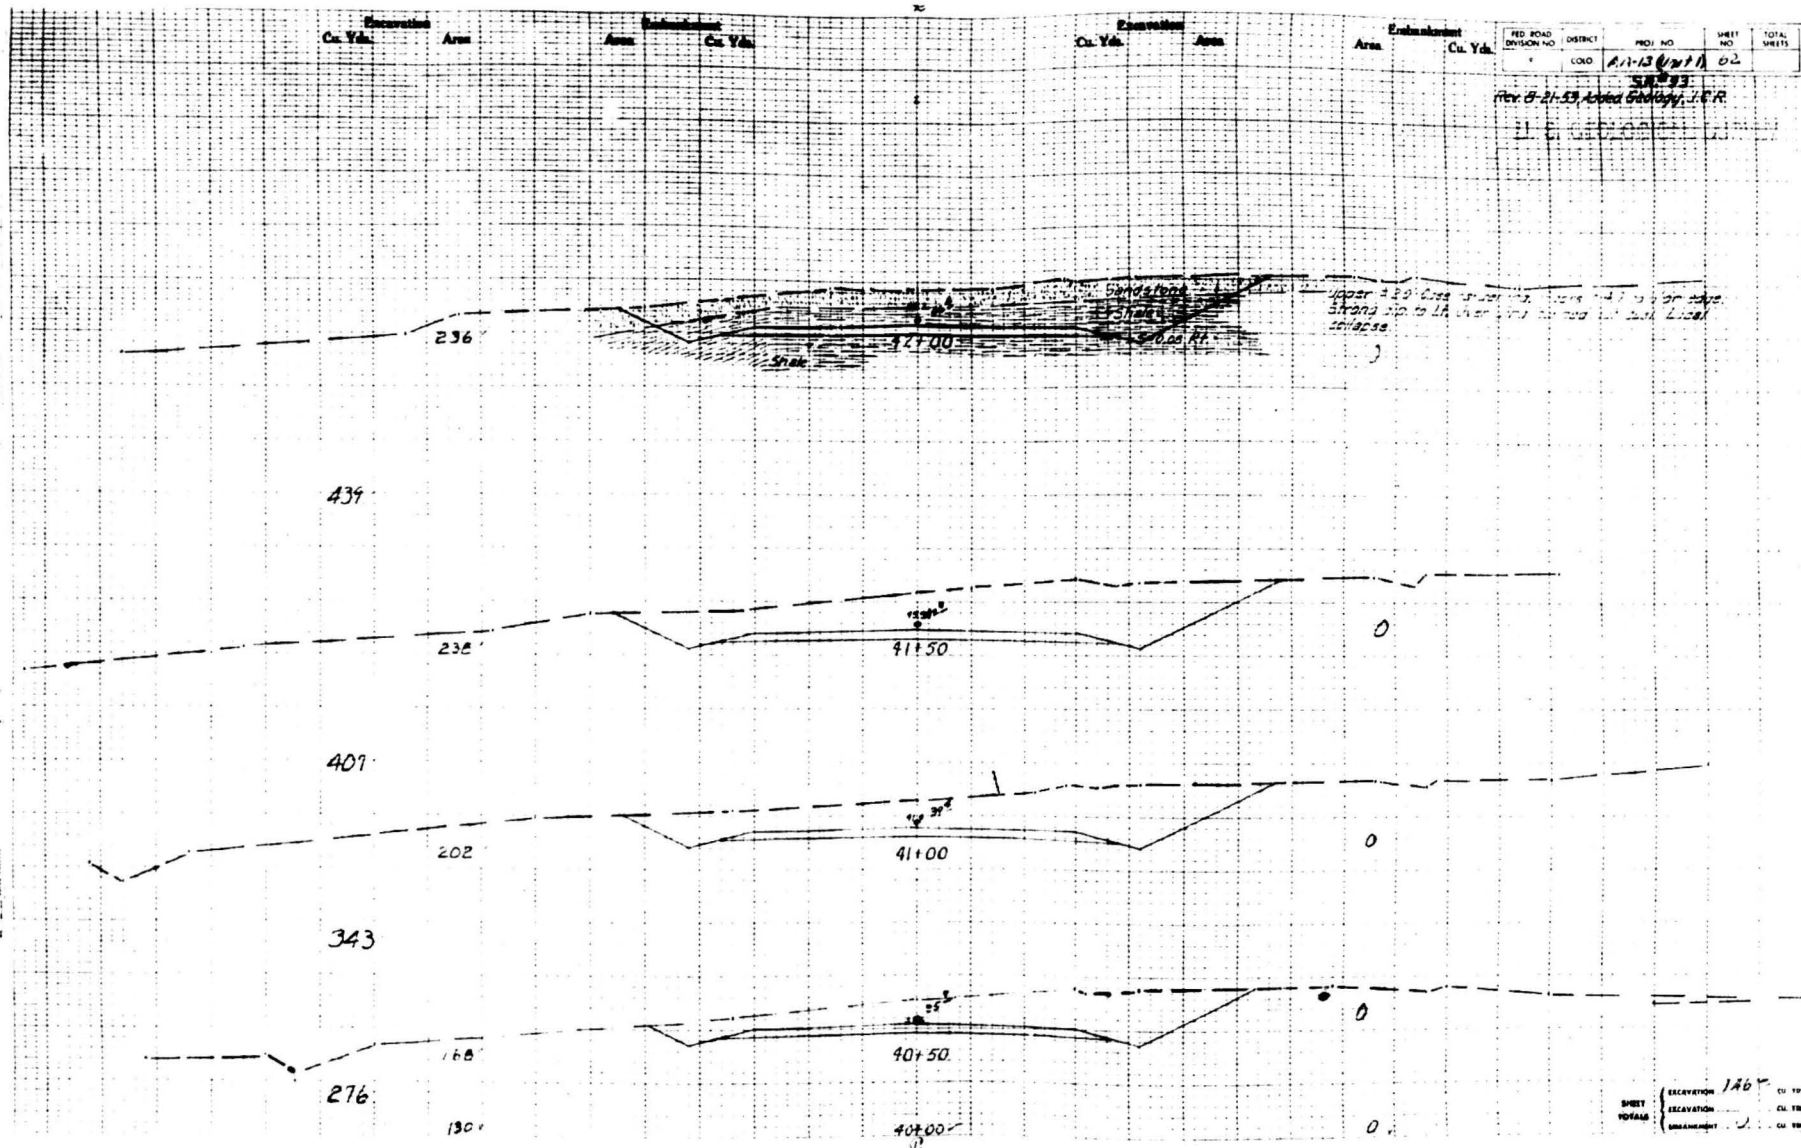

Excavation  
Cu. Yds. Area

Embankment  
Cu. Yds. Area

Excavation  
Cu. Yds. Area

Embankment  
Cu. Yds. Area

FED. ROAD DIVISION NO.	DISTRICT	NO. 1 NO.	SHEET NO.	TOTAL SHEETS
V	COLO.	AA-13 (Unit 1)	69	

Rev. 8-21-53, Added Geology, J.C.R.  
Rev. 5-3-54, Geology, J.C.R.

U. S. GEOLOGICAL SURVEY

485  
1465

5250

S-15 ft.

0

Fault Zone

2250

1100

Sandstone

5200

Shale

S-15 ft.

0

Sandstone

1330

2310

51+50

S-15 ft.


0

1165

51400

0

SHEET	EXCAVATION	6025	CU. YDS.
TOTALS	EXCAVATION	0	CU. YDS.
	EMBANKMENT	0	CU. YDS.

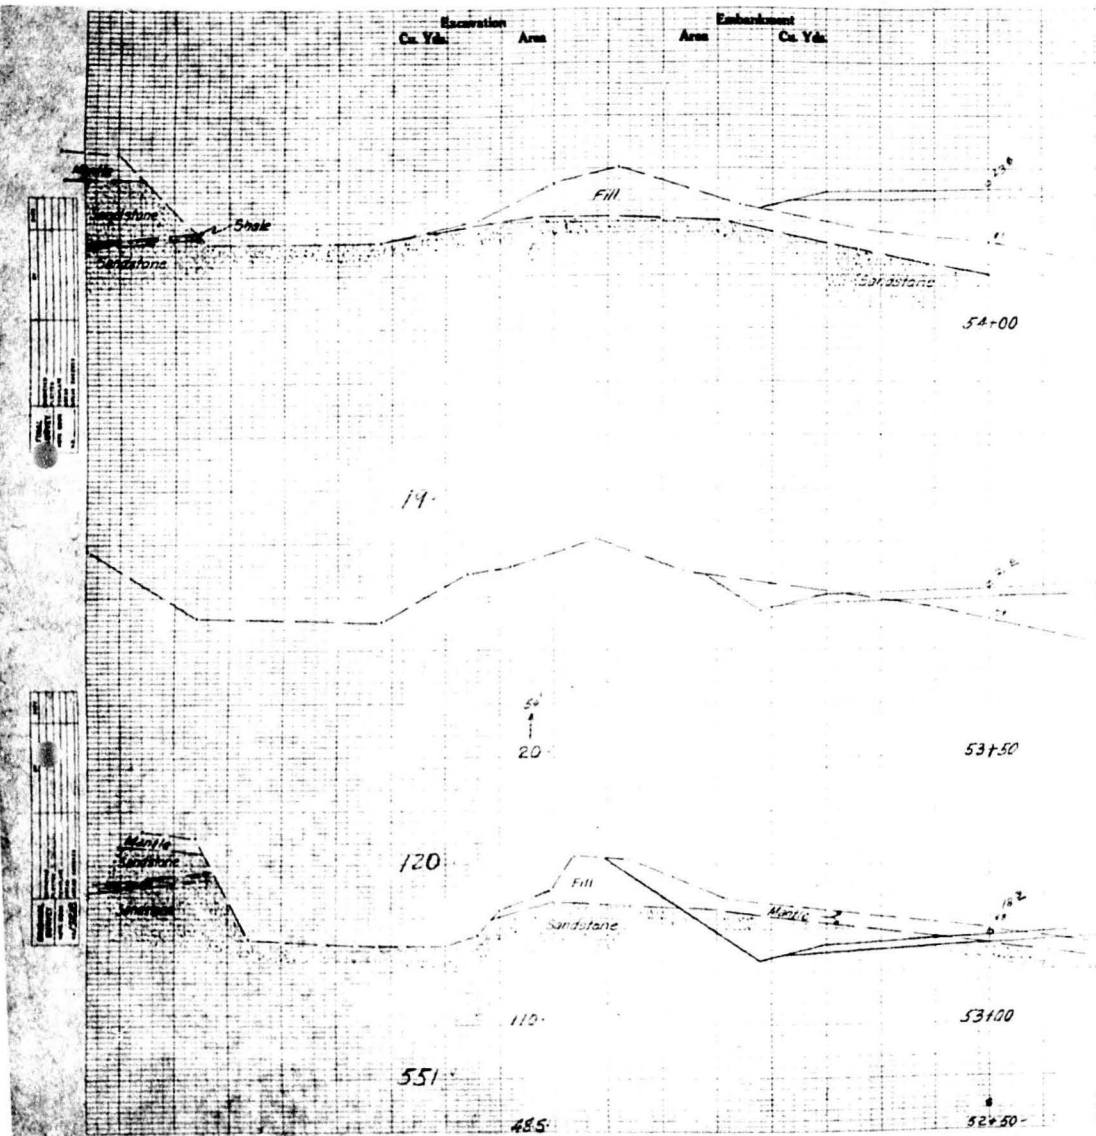

Excavation  
Cu. Yds. Area

Embankment  
Area Cu. Yds.

AA-13 (Unit 1) 6-2

S.H. 93



U. S. GEOLOGICAL SURVEY

SHEET TOTALS

EXCAVATION	640	- CU. YDS.
EMBANKMENT	507	- CU. YDS.

Excavation  
Cu. Yds. Area

Embankment  
Area Cu. Yds.


Excavation  
Cu. Yds. Area

Embankment  
Area Cu. Yds.

FED. ROAD DIVISION NO.	DISTRICT	PROJ. NO.	SHEET NO.	TOTAL SHEETS
9	COLD	AA-13 (Unit 1)	13	

SN#93  
Rev. 8-21-53, Added Geology, J.C.R.  
Rev. 5-2-54, Geology, J.C.R.

U. S. GEOLOGICAL SURVEY

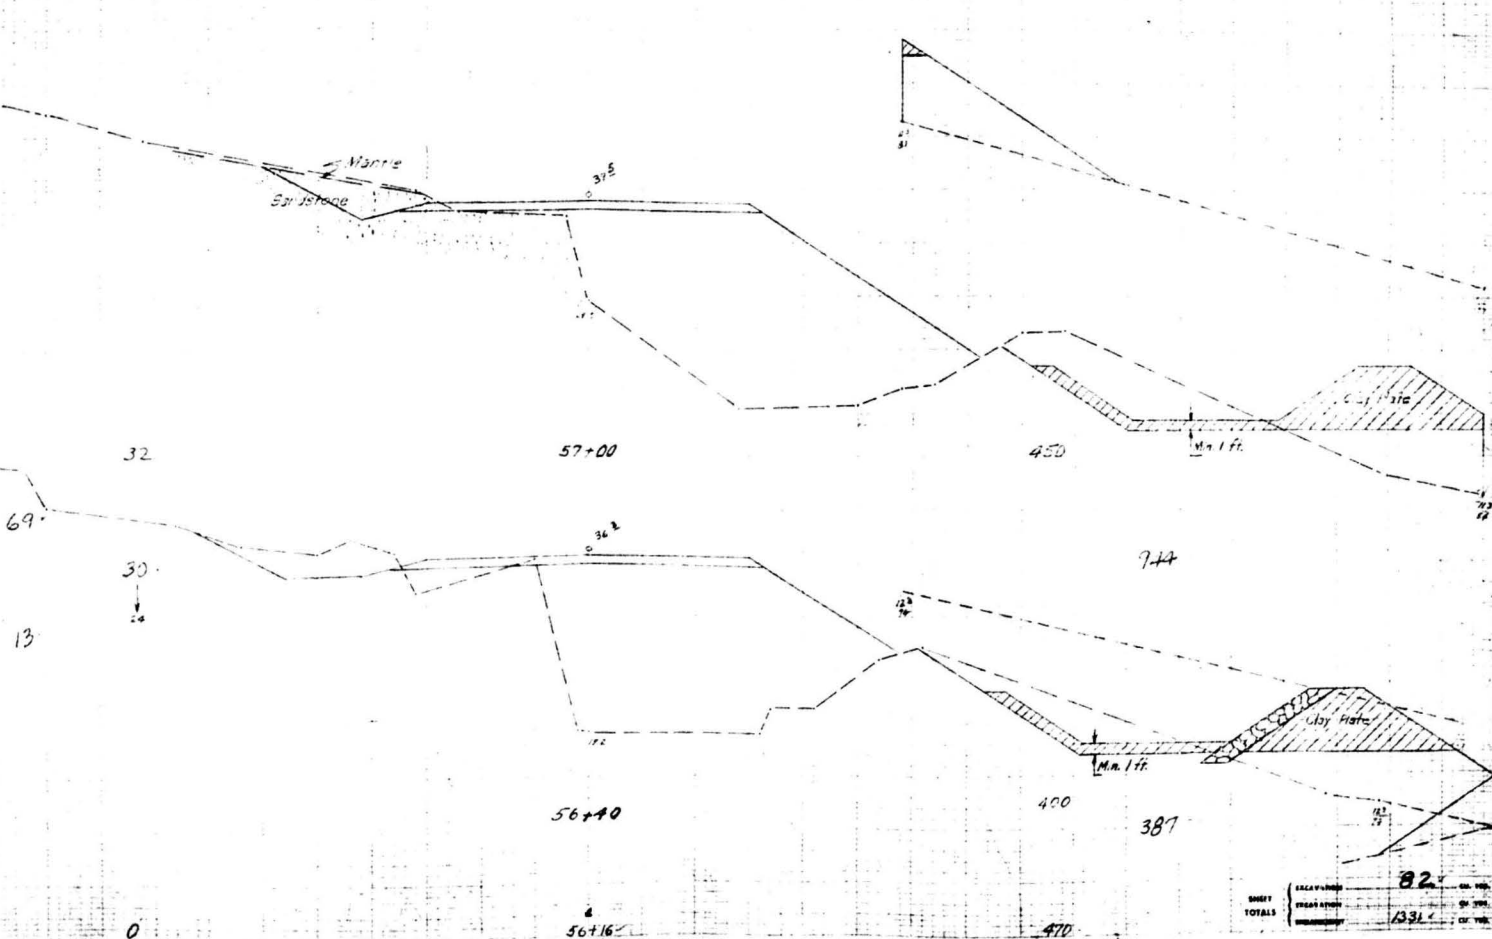

SHEET	TOTALS	EXCAVATION	EMBANKMENT	GEOL. COR.
82	1331			

Excavation  
Cu. Yds. Area

Embankment  
Area Cu. Yds.


Excavation  
Cu. Yds. Area

Embankment  
Area Cu. Yds.

110 ROAD	DISTRICT	PROJ. NO.	SHEET NO.	TOTAL SHEETS
		AA-13 (Unit 1)	14	

SH-93  
Rev. 2-28-55  
Rev. 3-3-54  
Geology, M.C.H.

U. S. D. E. P. Y

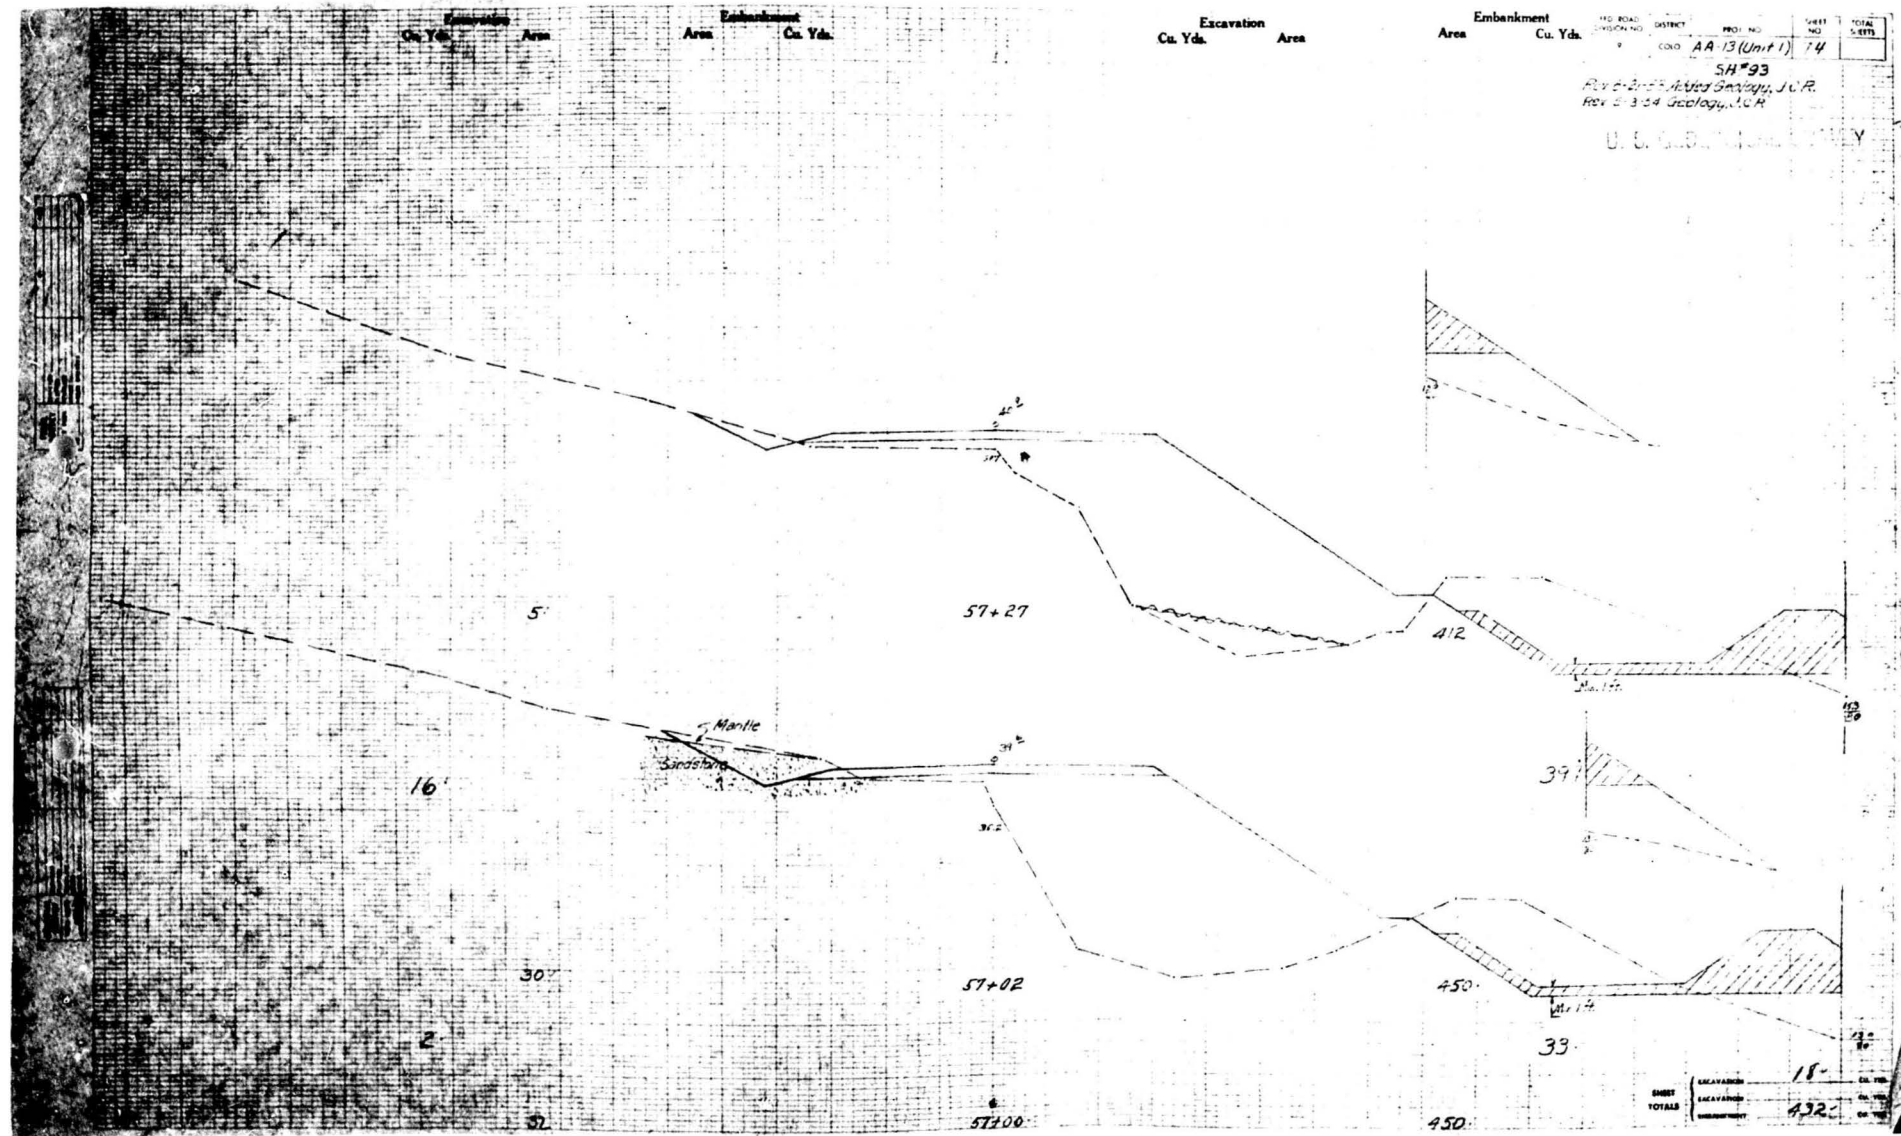



Excavation  
Cu. Yds. Area

Embankment  
Area Cu. Yds.

Excavation  
Cu. Yds. Area

Embankment  
Area Cu. Yds.

NO. 13 (Unit 1)  
SH#93  

25

58+50

58+50

208

93

75

58+00

58+00

375

34

80

57+88

354

162

SHEET TOTALS	EXCAVATION	EMBRANKMENT	CU. YDS.
	127	77	CU. YDS.


Excavation  
Cu. Yds. Area

Embankment  
Area Cu. Yds.

Excavation  
Cu. Yds. Area

Embankment  
Area Cu. Yds.

NO. ROAD  
SECTION NO.  
SHEET NO.  
TOTAL SHEETS  
AA-13 (1 of 1) 74  
54-93  
May 6 3 1964  
R.D. 3 24 3000 ft. C.R.

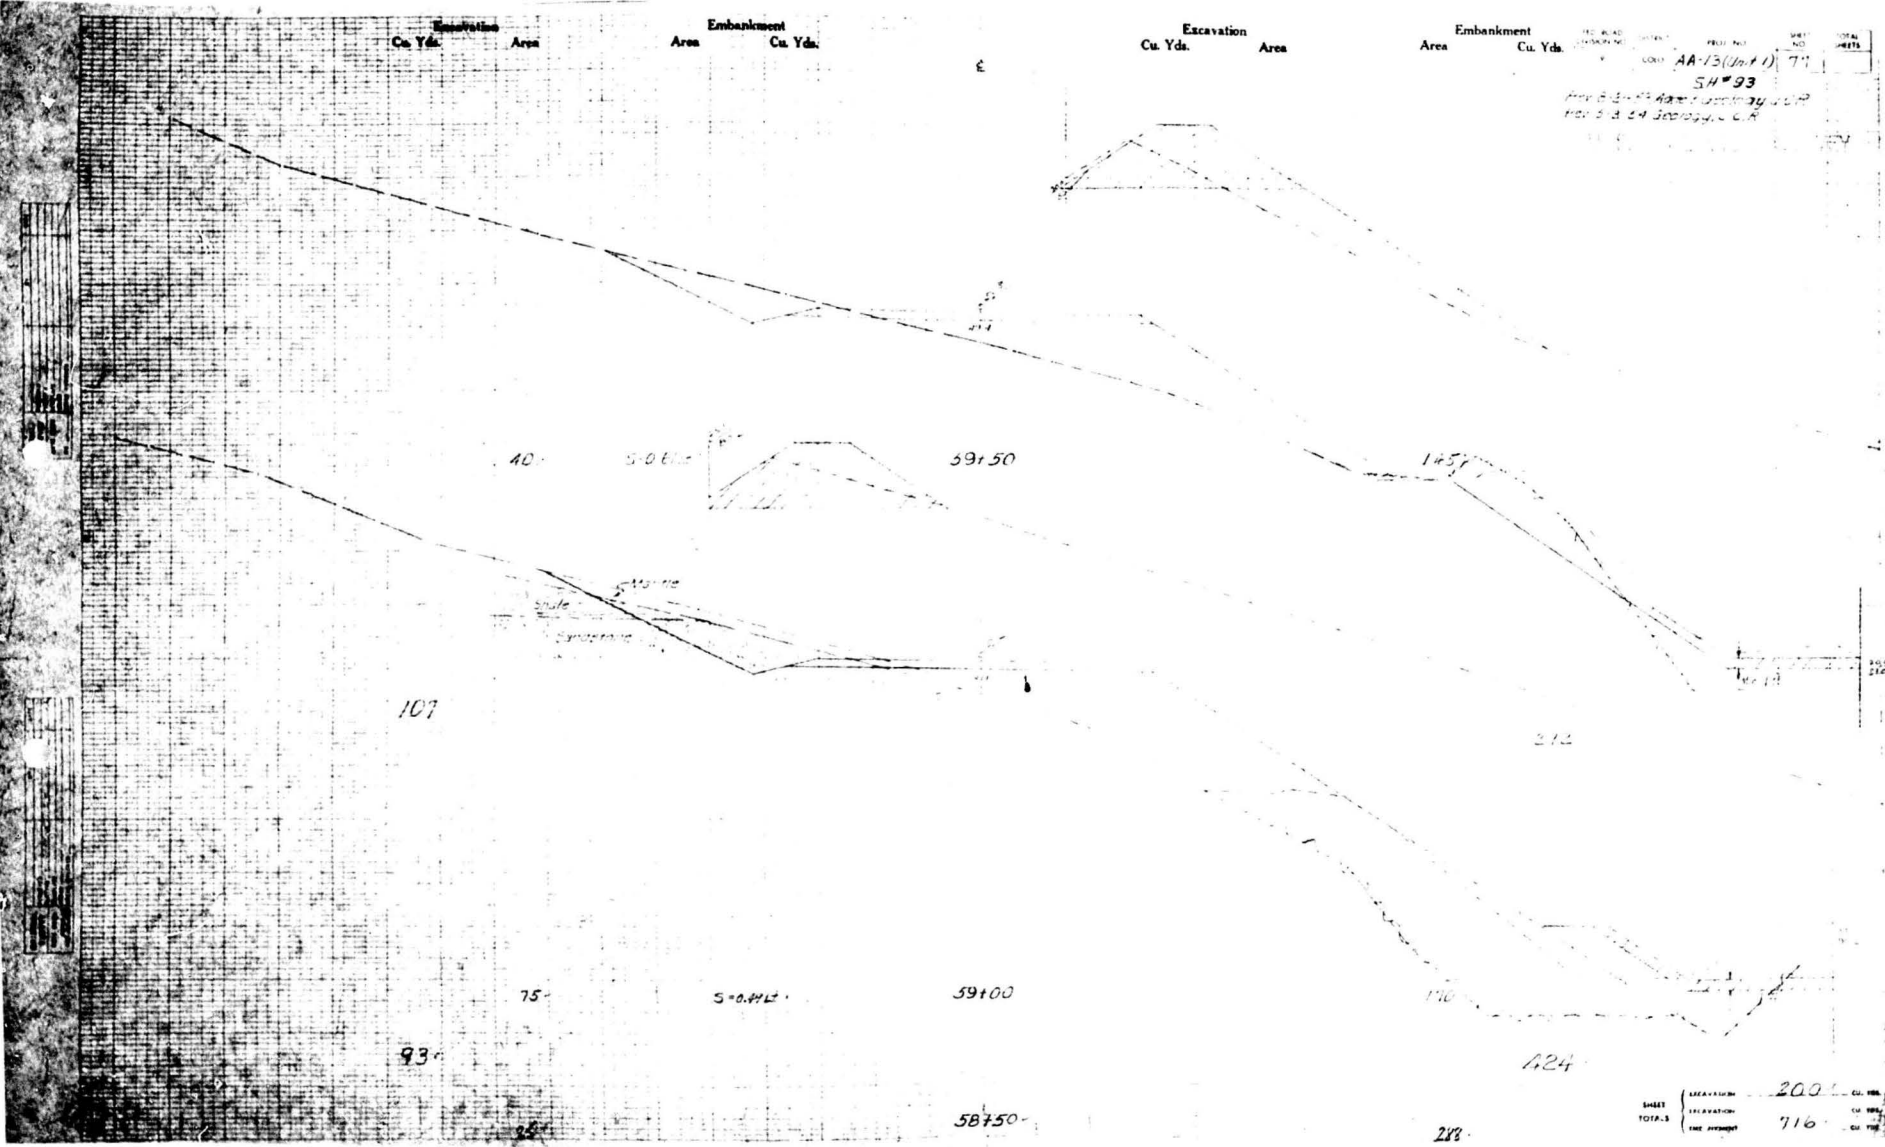

SHEET TOTALS  
EXCAVATION  
EMPAVEMENT  
AREA VOLUME  
200  
716  
CU. YDS.

Excavation  
Cu. Yds. AreaEmbankment  
Area Cu. Yds.Excavation  
Cu. Yds. AreaEmbankment  
Area Cu. Yds.FED. ROAD DISTRICT PROJ. NO. NO. SHEET  
DIVISION NO. DISTRICT  
9 COLO. AA-3 (Unit 1) 78

SH-93

Rev. 5-21-53 Actual Geology, J.C.R.  
Rev. 5-18-54 Geology, J.C.R.

U. S. GEOLOGICAL SURVEY

Interbedded  
Sandstones, Shales  
and CoalsRef to A Profile  
and Page 17 of  
Geology report.

Mudite

602

580

61+00 - 21' 50" CMP Cross Cut vert = 5.25'

shale

5+0.634'

Sandstone

61+00

85

50

58

580

181

83

60

5+0.634'

60+50

110

120

Sandstone

Mudite

Shale

5+0.634'

60+00

144

45

120

90

176

40

59+50

145

\* SHEET (EXCAVATION: 323' cu. yds.)  
TOTALS (EXCAVATION: 501' cu. yds.)  
(EMBANKMENT: 0' cu. yds.)



Excavation Area  
Cu. Yds. Area

Excavation Area  
Cu. Yds. Area

Embankment Area  
Cu. Yds.

FED. ROAD DISTRICT NO.	DISTRICT	PROJ. NO.	SHEET NO.	TOTAL SHEETS
1	1	AA-13 (Unit 1)	50	

SH-93

Rev. 8-2-55 Areas Deleted J.C.F.  
Rev. 8-2-54, Geology, J.C.F.

U. S. GEOLOGICAL SURVEY

190'

361'

5+0.63 LE

63+50

5  
↓  
20

2

200'

394'

5+0.63 LE

63+00

Coal

Shale

Shale (Light)

Shale (Gray)

Shale (Light)

Coal

225'

426'

5+0.63 LE

62+50

62+00

SHEET TOTALS	EXCAVATION	EMBANKMENT	CU. YDS.
	1181'	2'	



Excavation  
Cu. Yds. Area

Embankment  
Cu. Yds. Area


Excavation  
Cu. Yds. Area

Embankment  
Cu. Yds. Area

FED. ROAD DIVISION NO.	DISTRICT	PROJ. NO.	SHEET NO.	TOTAL SHEETS
9	COLO.	AA-13 (Unit D)	81	

5.14.53  
Rev. 8-21-53 Added Geology, J.G.P.

U.S. GEOLOGICAL SURVEY

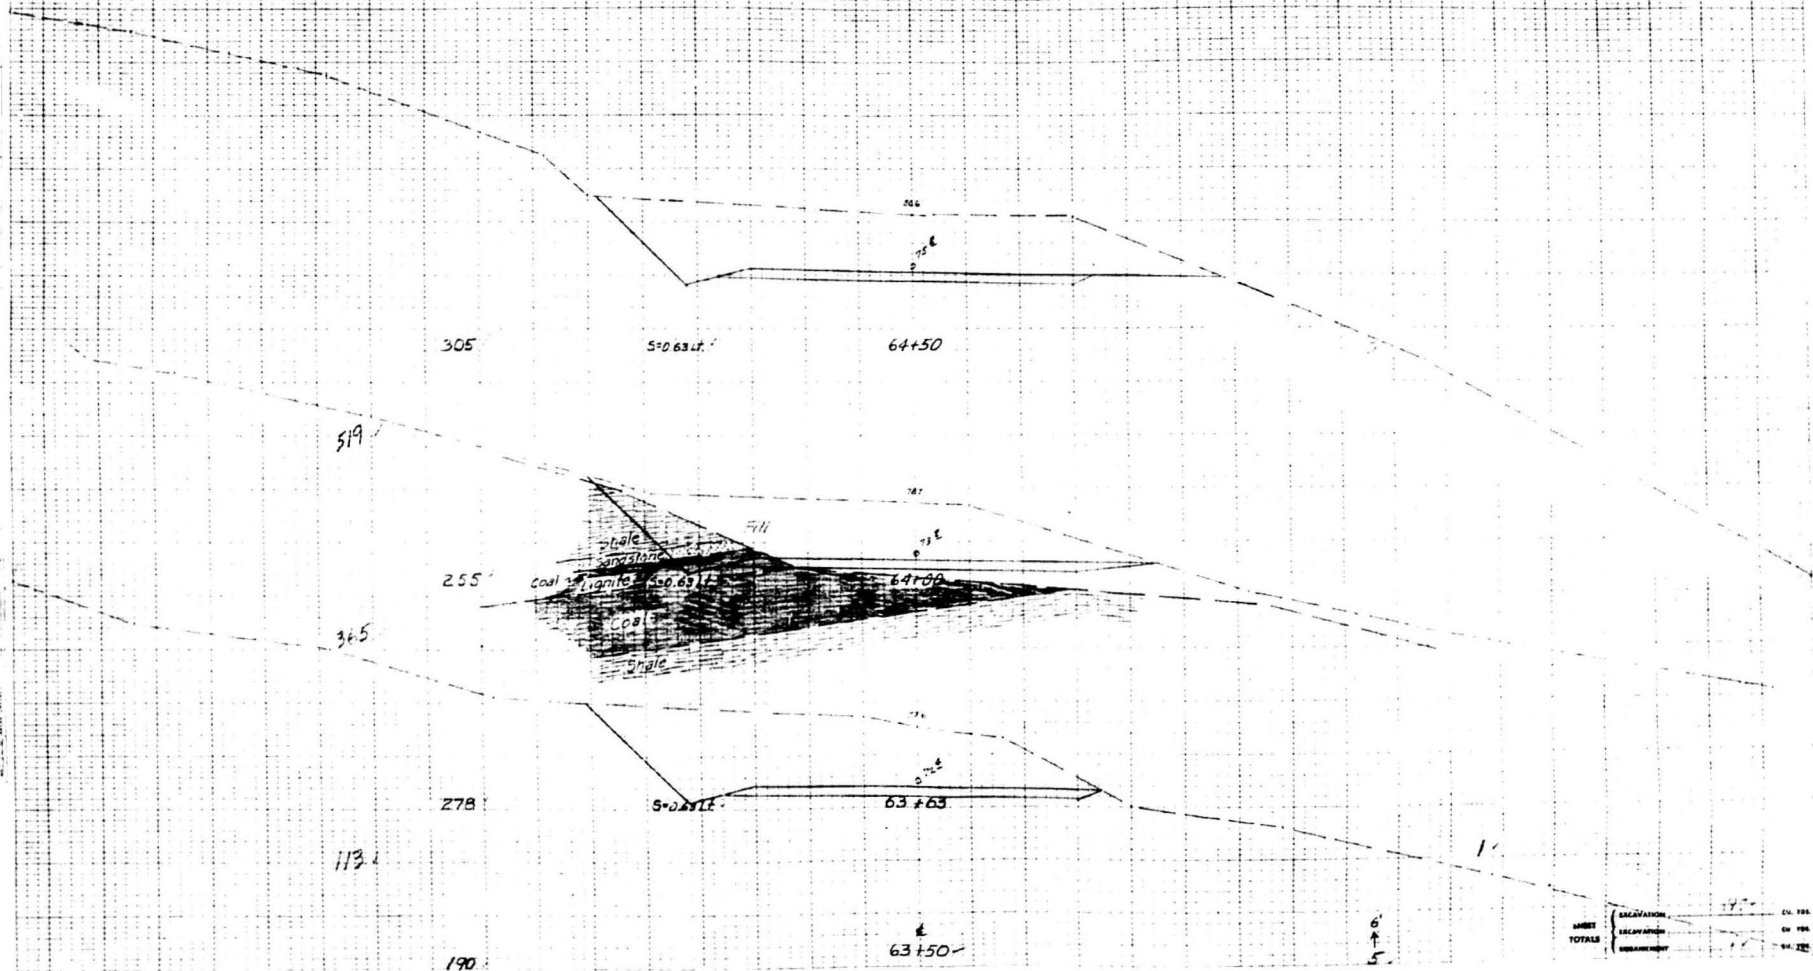




Elevation  
 Co. Yds. Area  
 Elevation  
 Co. Yds. Area  
 Elevation  
 Co. Yds. Area  
 Elevation  
 Co. Yds. Area

FED. ROAD DISTRICT	PROJ. NO.	SHEET NO.	TOTAL SHEETS
9	AA-13 (Unit 1)	83	

Sec 9-21-33 Adena Geology, J.C.R.  
 U.S. GEOLOGICAL SURVEY

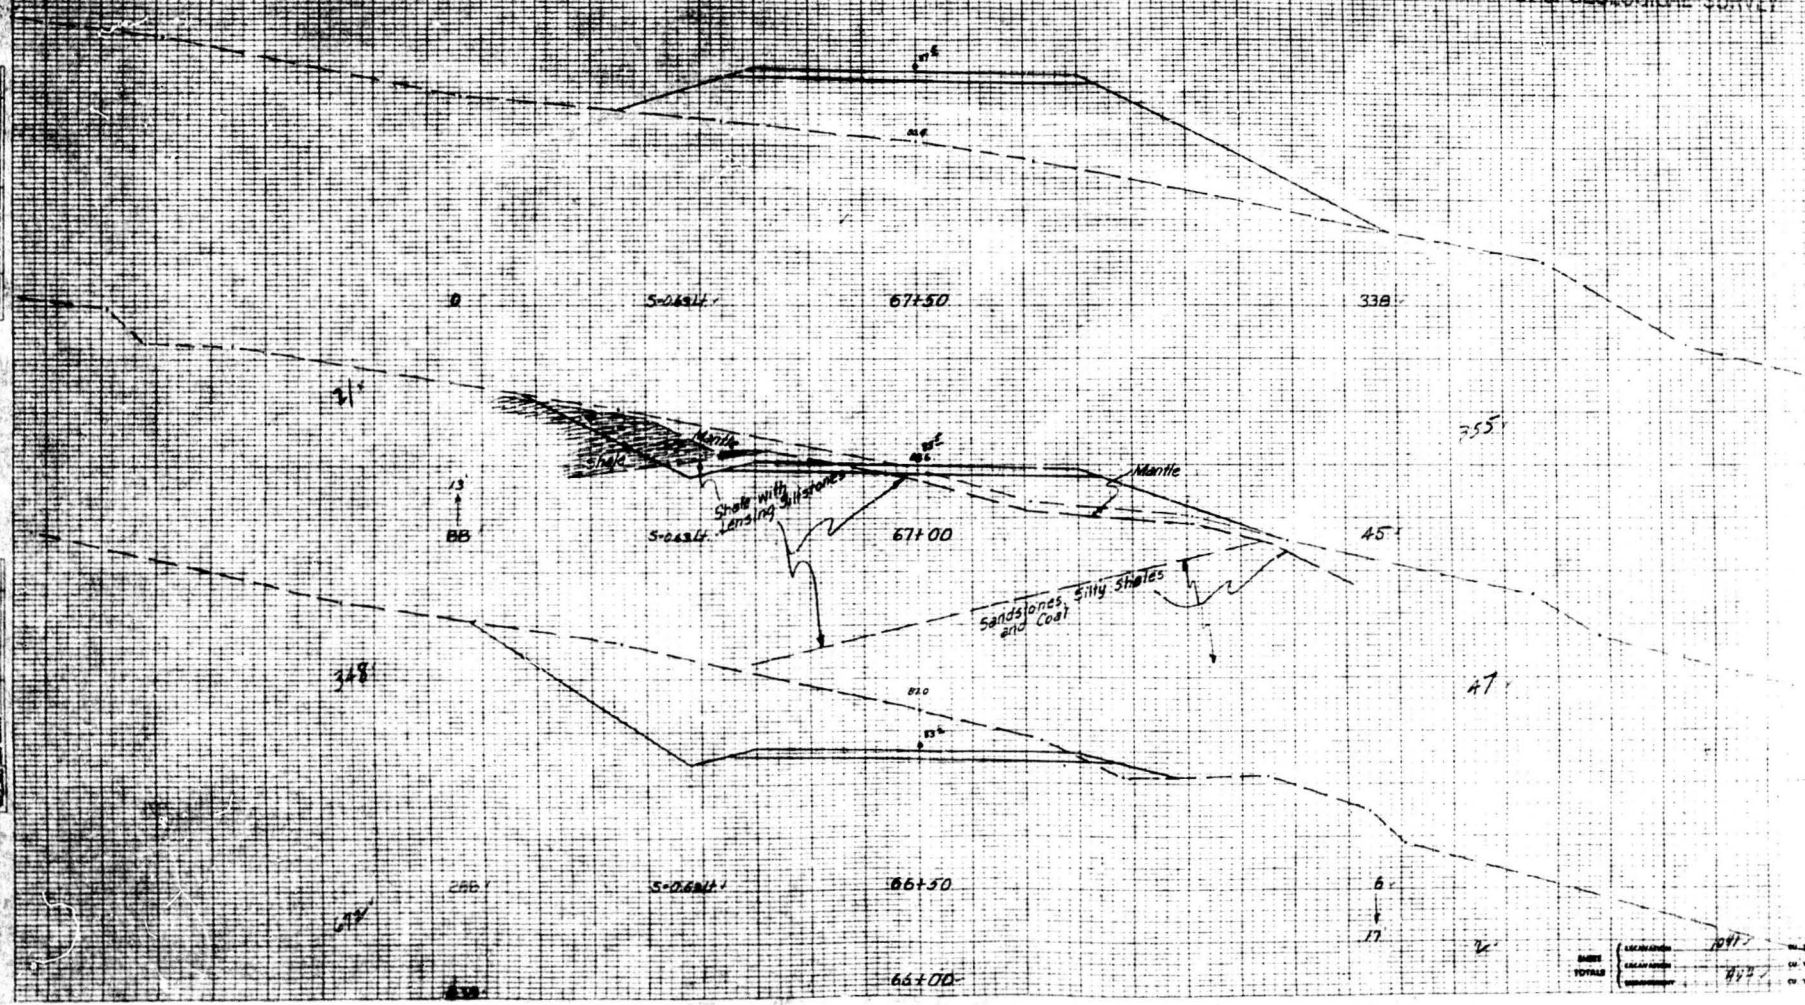

SHEET	DESCRIPTION	DATE
TOTAL	447	1947




Subsurface Area      Excavation Area      Subsurface Area  
 Co. Yds. Area      Co. Yds. Area      Co. Yds. Area

FED. ROAD DIVISION NO.	DISTRICT	PROJECT NO.	SHEET NO.	TOTAL SHEETS
9	COLO.	AA-13 (Unit 1)	90	

5.11.59  
 Rev. B-21-59: Added Geology, J.A.R.

U.S. GEOLOGICAL SURVEY

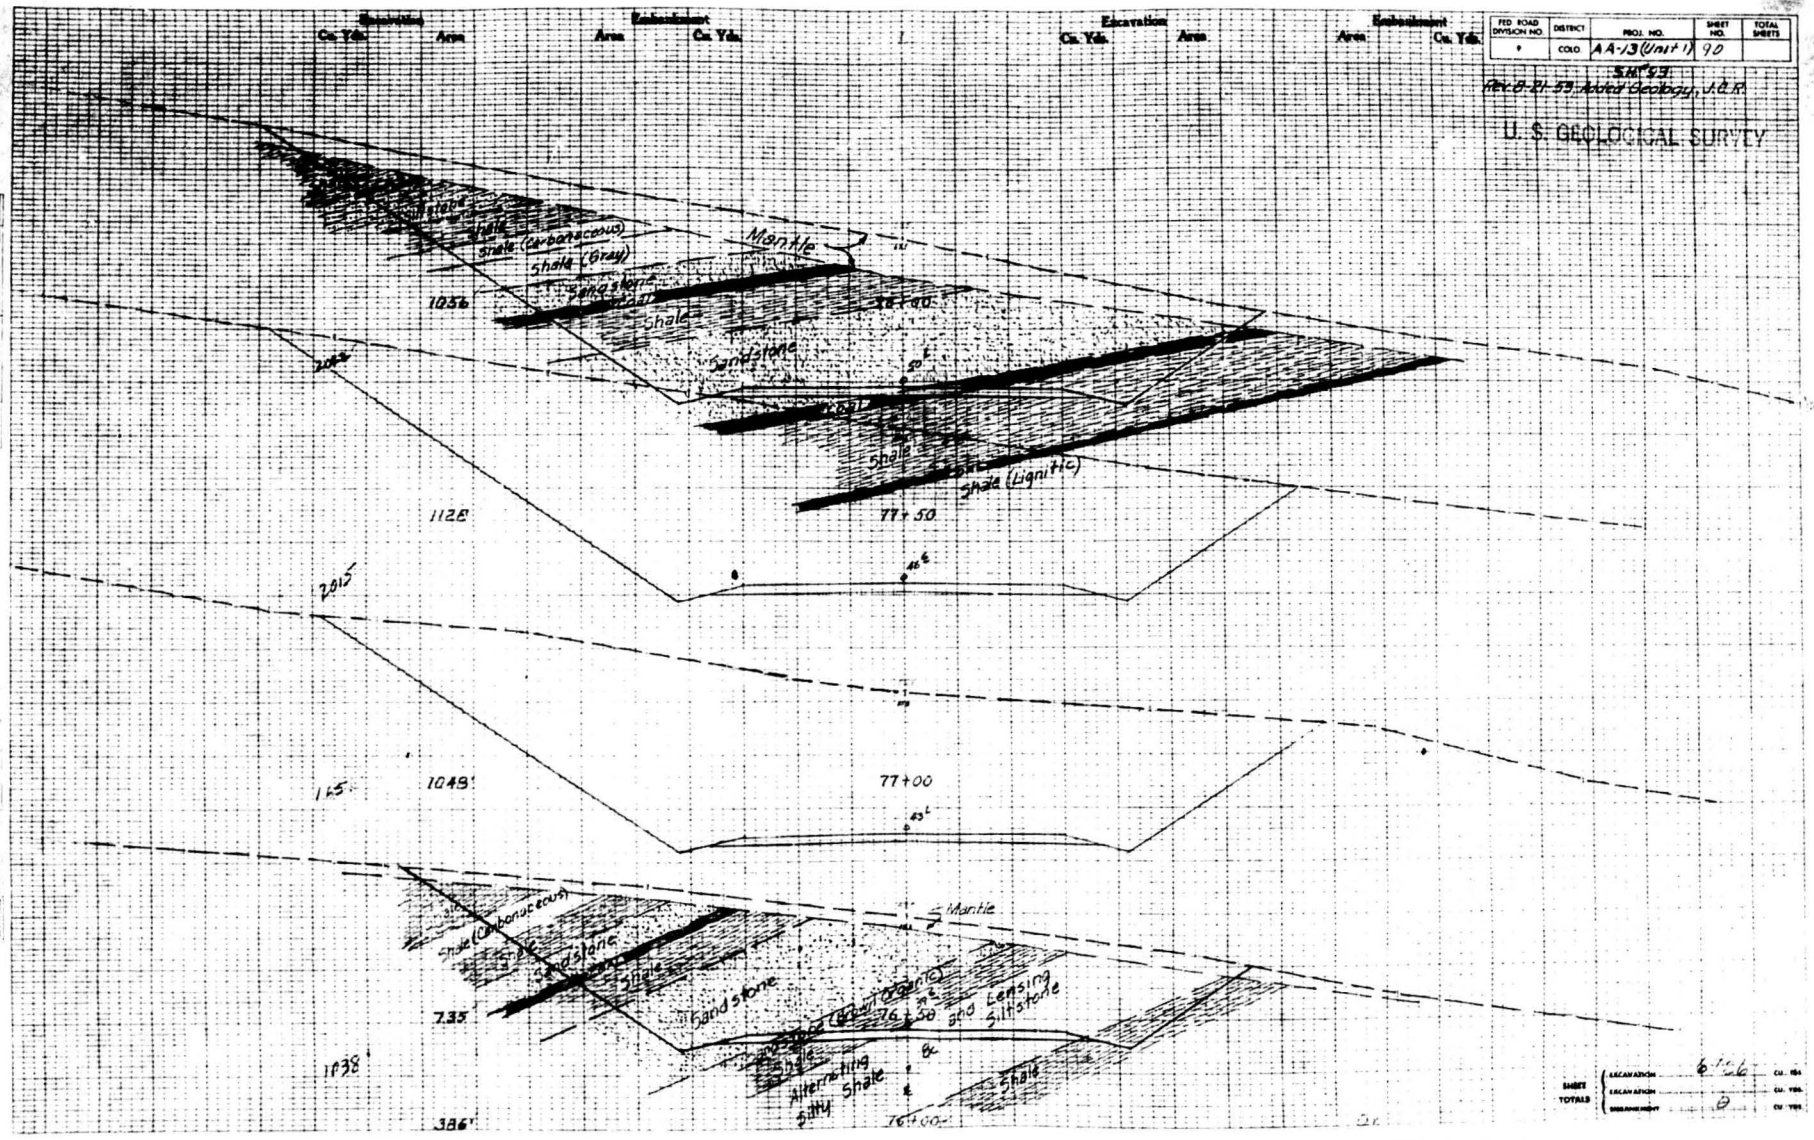

SHEET	6156	CU. YDS.
TOTALS	0	CU. YDS.

Excavation  
Cu. Yds. Area

Excavation  
Cu. Yds. Area


Excavation  
Cu. Yds. Area

Excavation  
Cu. Yds. Area

PROJECT NO.	SHEET NO.	TOTAL SHEETS
4-1-13 (100+1)	27	

Rev. 8-21-53, Added Geology, J.C.R.

U.S. GEOLOGICAL SURVEY

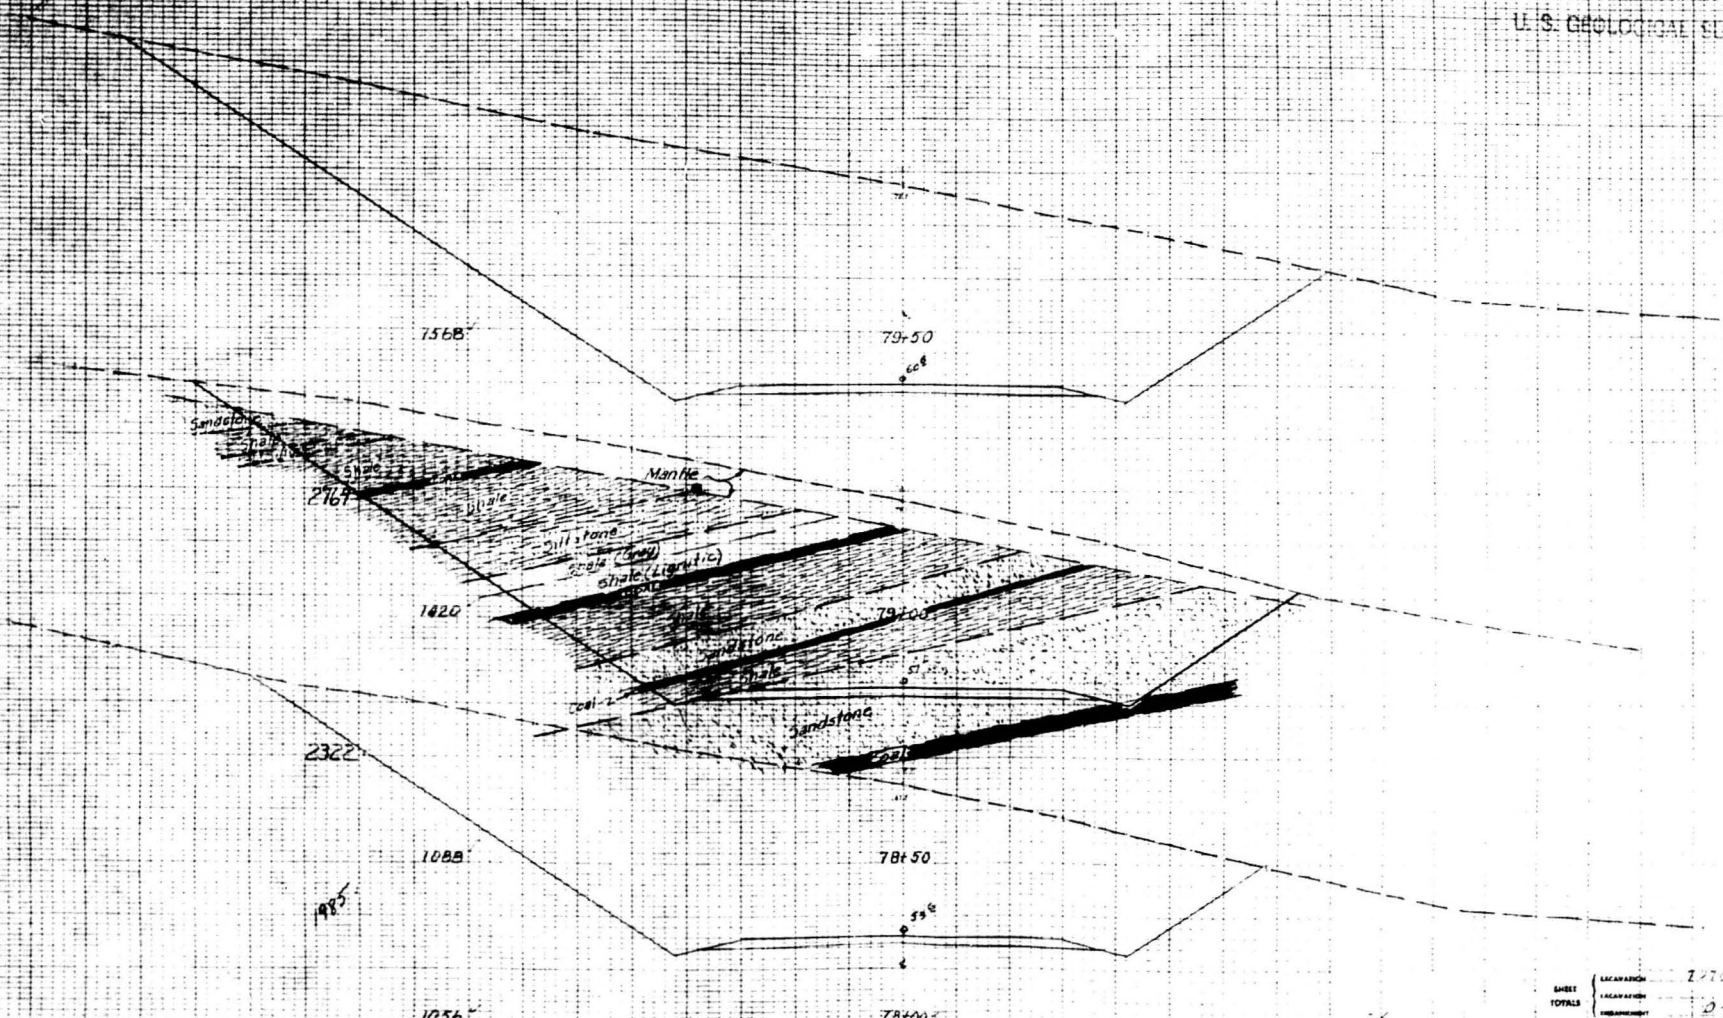

SHEET TOTALS	SACRAMENTO	CU. YDS.
	270	
	0	

Excavation  
Cu Yds. Area

Embankment  
Area Cu Yds.

Excavation  
Cu Yds. Area

Embankment  
Area Cu Yds.

FILE NO. & DIVISION NO.	DISTRICT	PROJ. NO.	SHEET NO.	TOTAL SHEETS
9	COLD	A11-13 (Unit 1)	92	

Rev. 8-21-53, ~~Revised Geology~~ J.C.P.

J.S. CLEGG

388

81+00

1037

1034

80+50

Sandstone

Shale

Coal

1508

26+8

1568

Marble

Siltstone

Shale

Shale (Carbonaceous)

Sandstone

80+00

79+50

SHEET	EXCAVATION	CU. YDS.
TOTALS	EXCAVATION	CU. YDS.
	EMBANKMENT	CU. YDS.

65.0

2



Excavation  
Cu. Yds. Area

Embankment  
Area Cu. Yds.

Excavation  
Cu. Yds. Area

Embankment  
Area Cu. Yds.

FED. ROAD DISTRICT	PROJECT NO.	SHEET NO.	TOTAL SHEETS
9	11A-13 (Cont'd)	53	

5. H. 33  
Rex G. A. 53, H. 33, Geology, J.C.R.

U.S. GEOLOGICAL SURVEY


Embankment  
Cu. Yds. Area


Excavation  
Cu. Yds. Area

Embankment  
Cu. Yds. Area

Area (Unit 1)

S.H. #93  
Rev. 8-21-89 Auto. and Suppl. C.P.  
Rev. 8-21-89 Geology, J.C.R.

U.S.C.T. 100.107

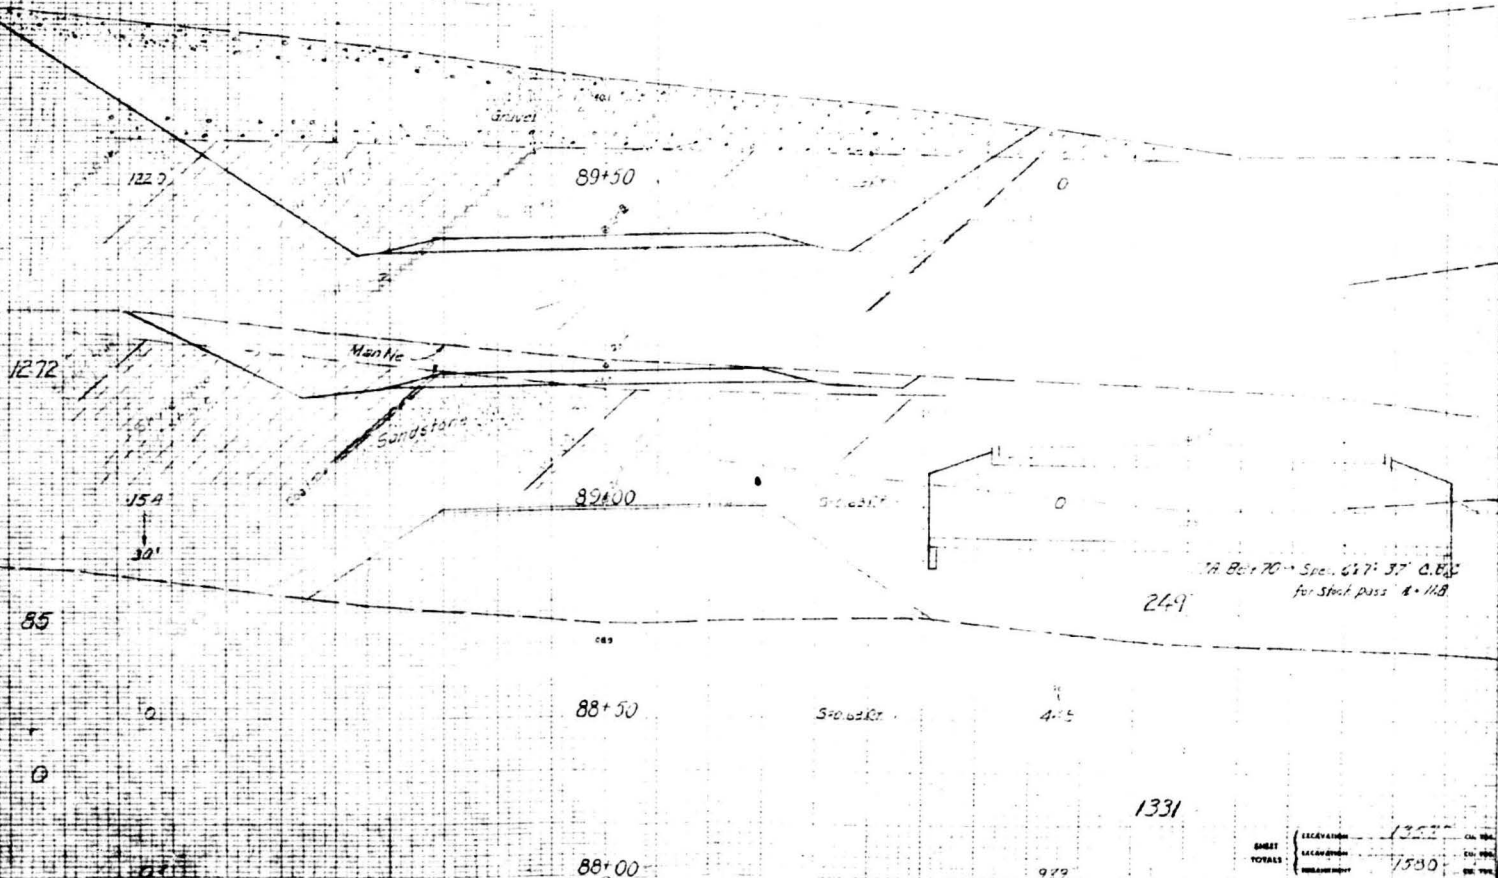

EMBED	EXCAVATION	1355	Cu. Yds.
TOTALS	EXCAVATION	1530	Cu. Yds.
	EMBEDMENT		Cu. Yds.

Excavation Area Cu. Yds. Area Cu. Yds. Embankment



Excavation Area Cu. Yds. Area

Embankment Area Cu. Yds.

PROJECT NO. DISTRICT NO. SHEET NO. TOTAL SHEETS  
 54793 AA-13 (Unit 1) 101

Rev. 8-21-53 Added Geology, U.S.G.S.  
 Rev. 3-3-54, Geology, U.S.G.S.

U. S. GEOLOGICAL SURVEY

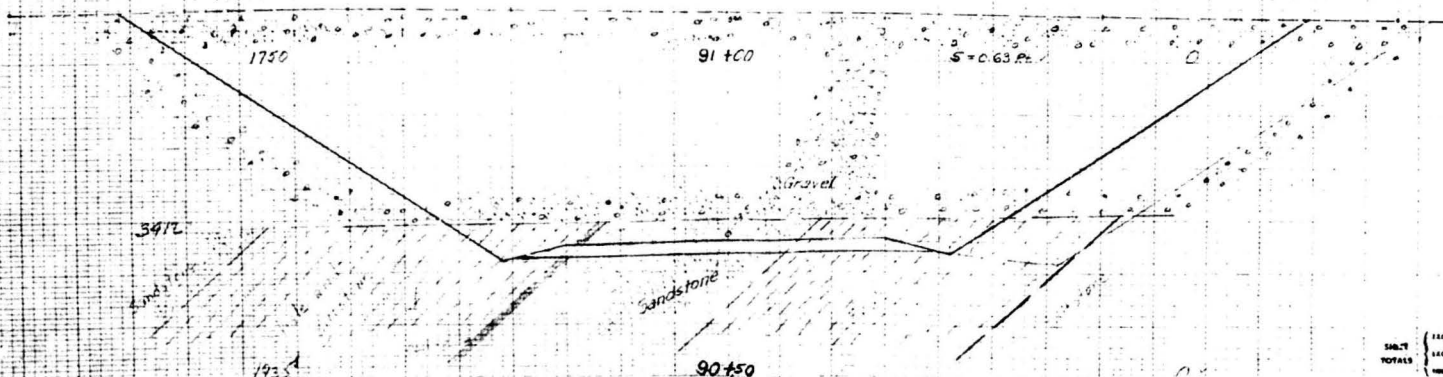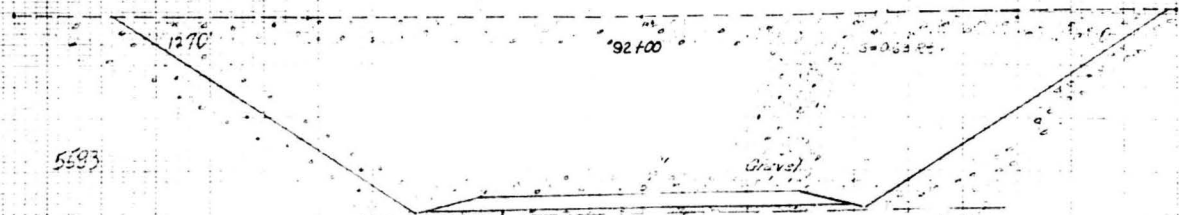


EXCAVATION 9005  
 EMBANKMENT 0  
 TOTALS

Substation Area Co. Yds. Substation Area Co. Yds. Substation Area Co. Yds. Substation Area Co. Yds.

RD. ROAD	DISTRICT	PROJ. NO.	SHEET NO.	TOTAL SHEETS
1	COLO.	A11-13(Unit 1)	105	

Rev. 8-21-59, 10/1/67 Geology, I.C.P.

U. S. GEOLOGICAL SURVEY

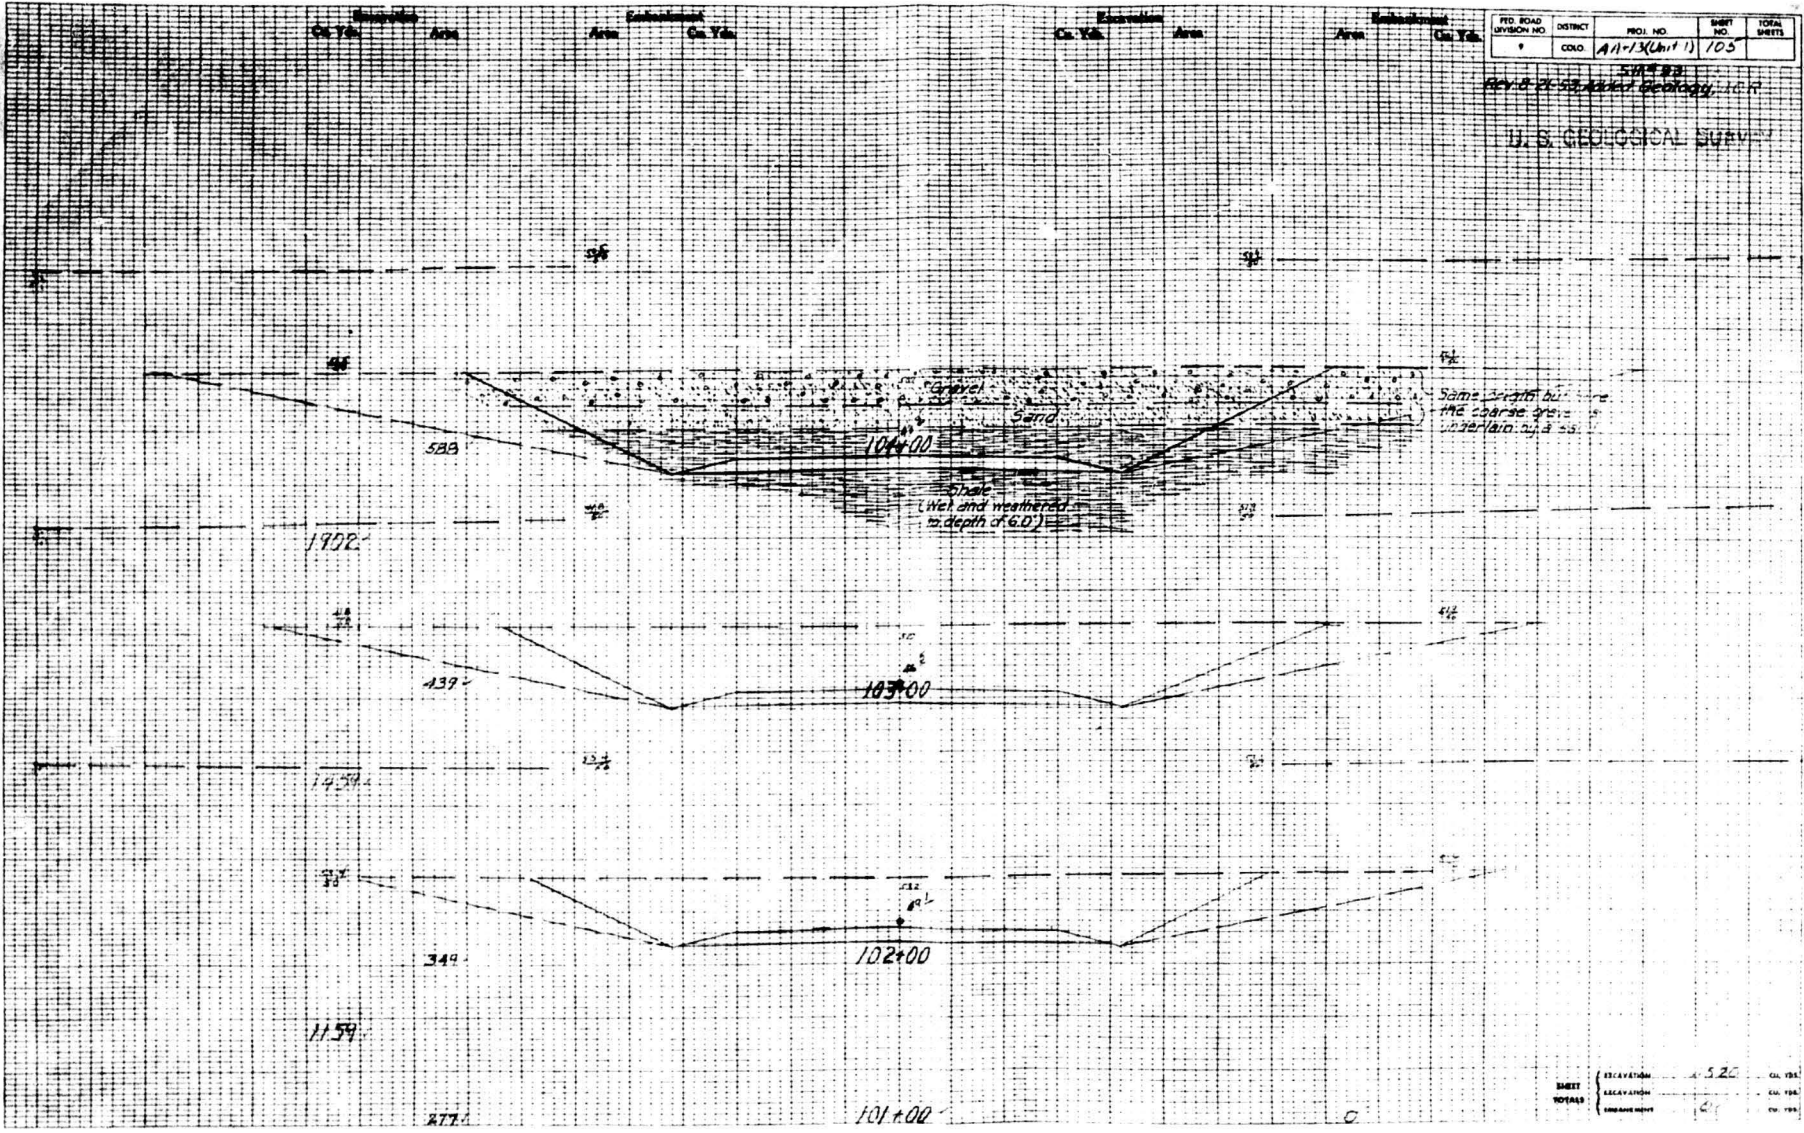

SHEET	EXCAVATION	5.25	CU. YDS.
TOTALS	EXCAVATION		CU. YDS.
	EMBANKMENT	1.00	CU. YDS.



Embankment  
Cu. Yds.

Area

Embankment  
Cu. Yds.

Excavation  
Cu. Yds.


Area

Embankment  
Cu. Yds.

FED. ROAD DIVISION NO.	DISTRICT	PROJ. NO.	SHEET NO.	TOTAL SHEETS
9	COLO.	9A-13(671+1)	106	

SH-223  
REV. 3-21-53 Added Geology, U.C.R.

U.S. GEOLOGICAL SURVEY

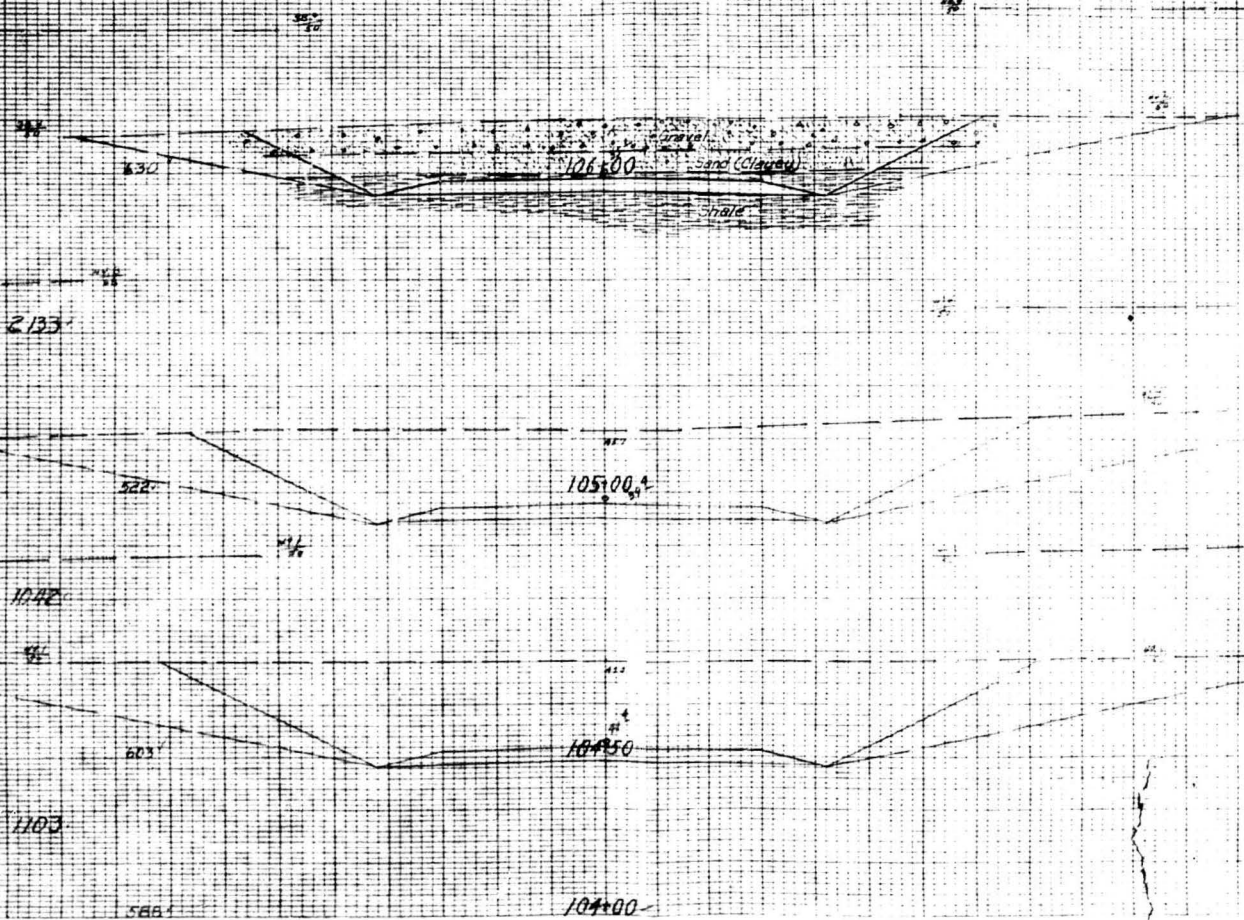

SHEET	ATTENTION	CL. 100.
TOTALS	9275	

Excavation  
Cu. Yds. Area

Embankment  
Cu. Yds. Area

Excavation  
Cu. Yds. Area

Embankment  
Cu. Yds. Area

FED. ROAD DIVISION NO.	DISTRICT	PROJ. NO.	SHEET NO.	TOTAL SHEETS
9	COLO.	1A-13 (Unit 1)	1/3	


SK# 23

Rev 8-21-33 under Geology J.C.R.

U. S. GEOLOGICAL SURVEY

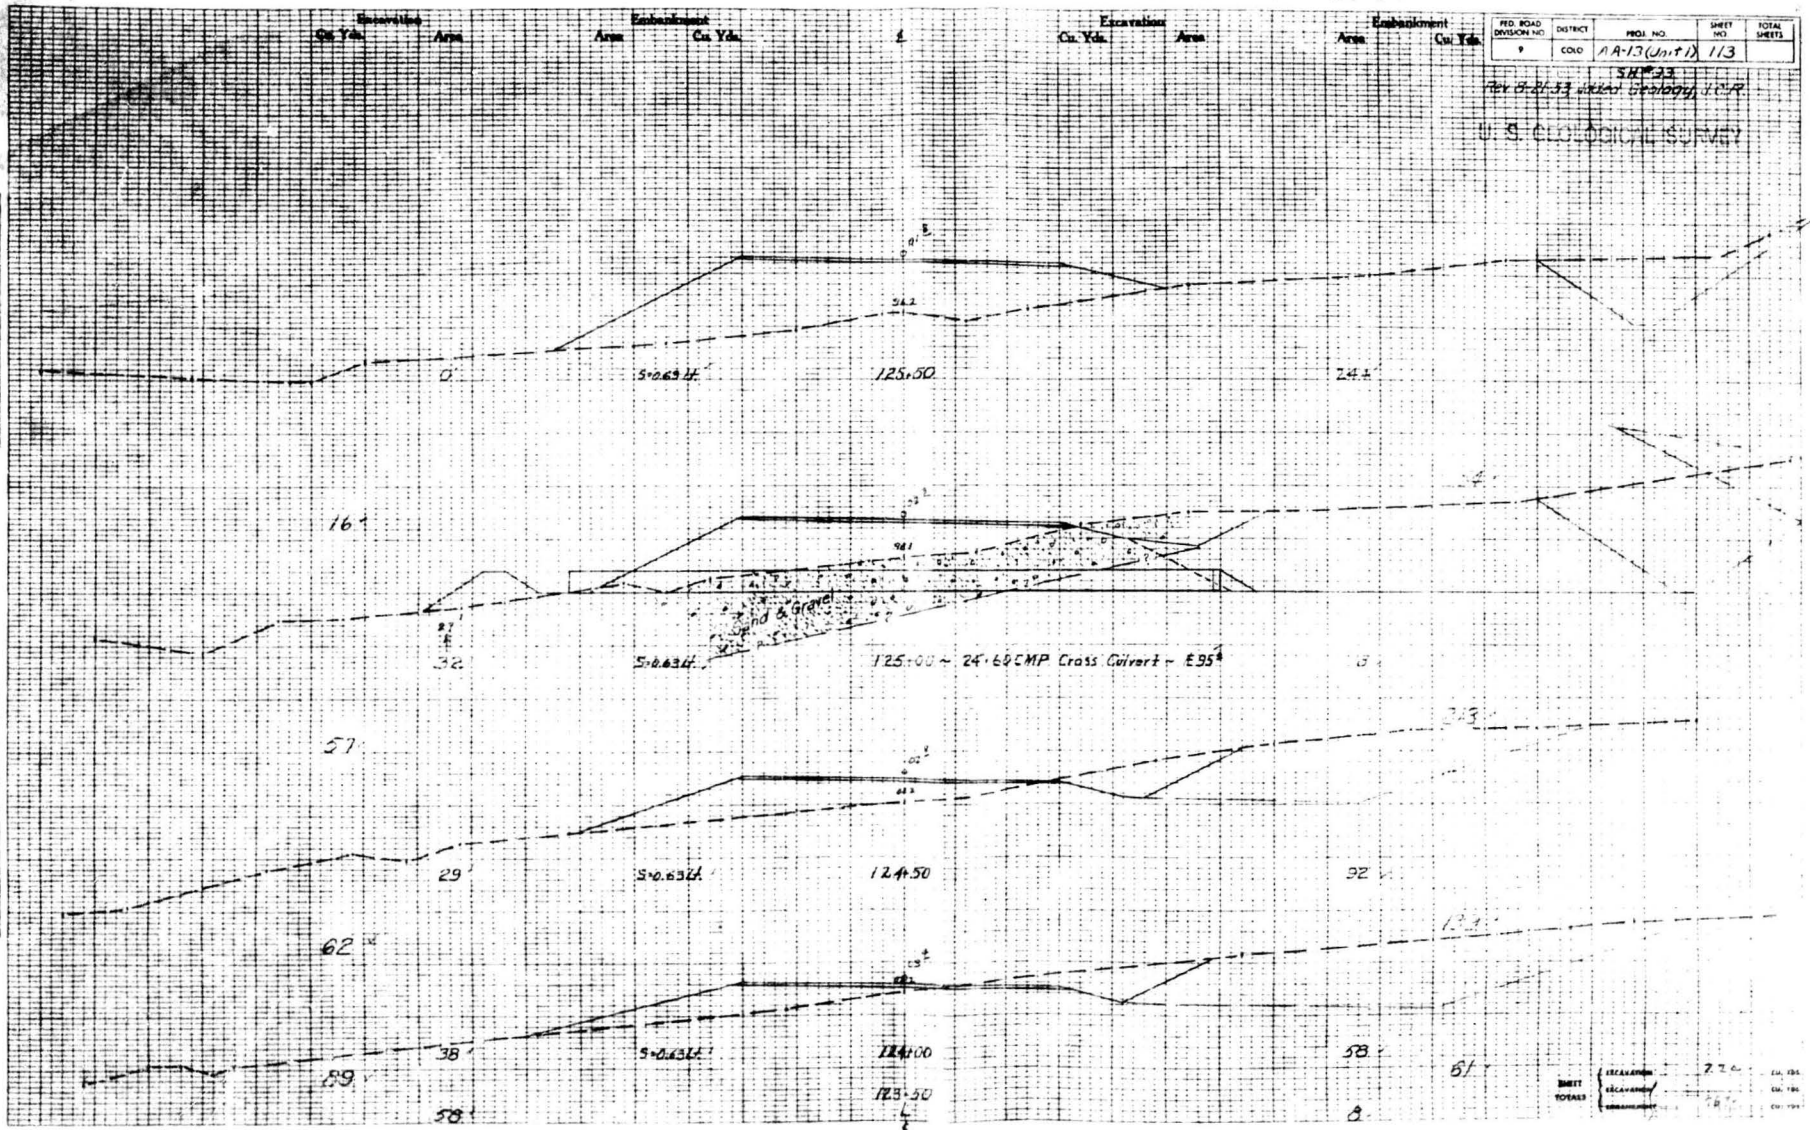


Excavation  
Cu. Yds. Area

Embankment  
Area Cu. Yds.

Excavation  
Cu. Yds. Area

Embankment  
Area Cu. Yds.


FED. ROAD DIVISION NO.	DISTRICT	PROJ. NO.	SHEET NO.	TOTAL SHEETS
9	COLO.	4113 (Unit 1)	113	

Rev. 8-11-53, Revised Geology, V.D.R.

U.S. GEOLOGICAL SURVEY

DATE	BY	REVISION

DATE	BY	REVISION

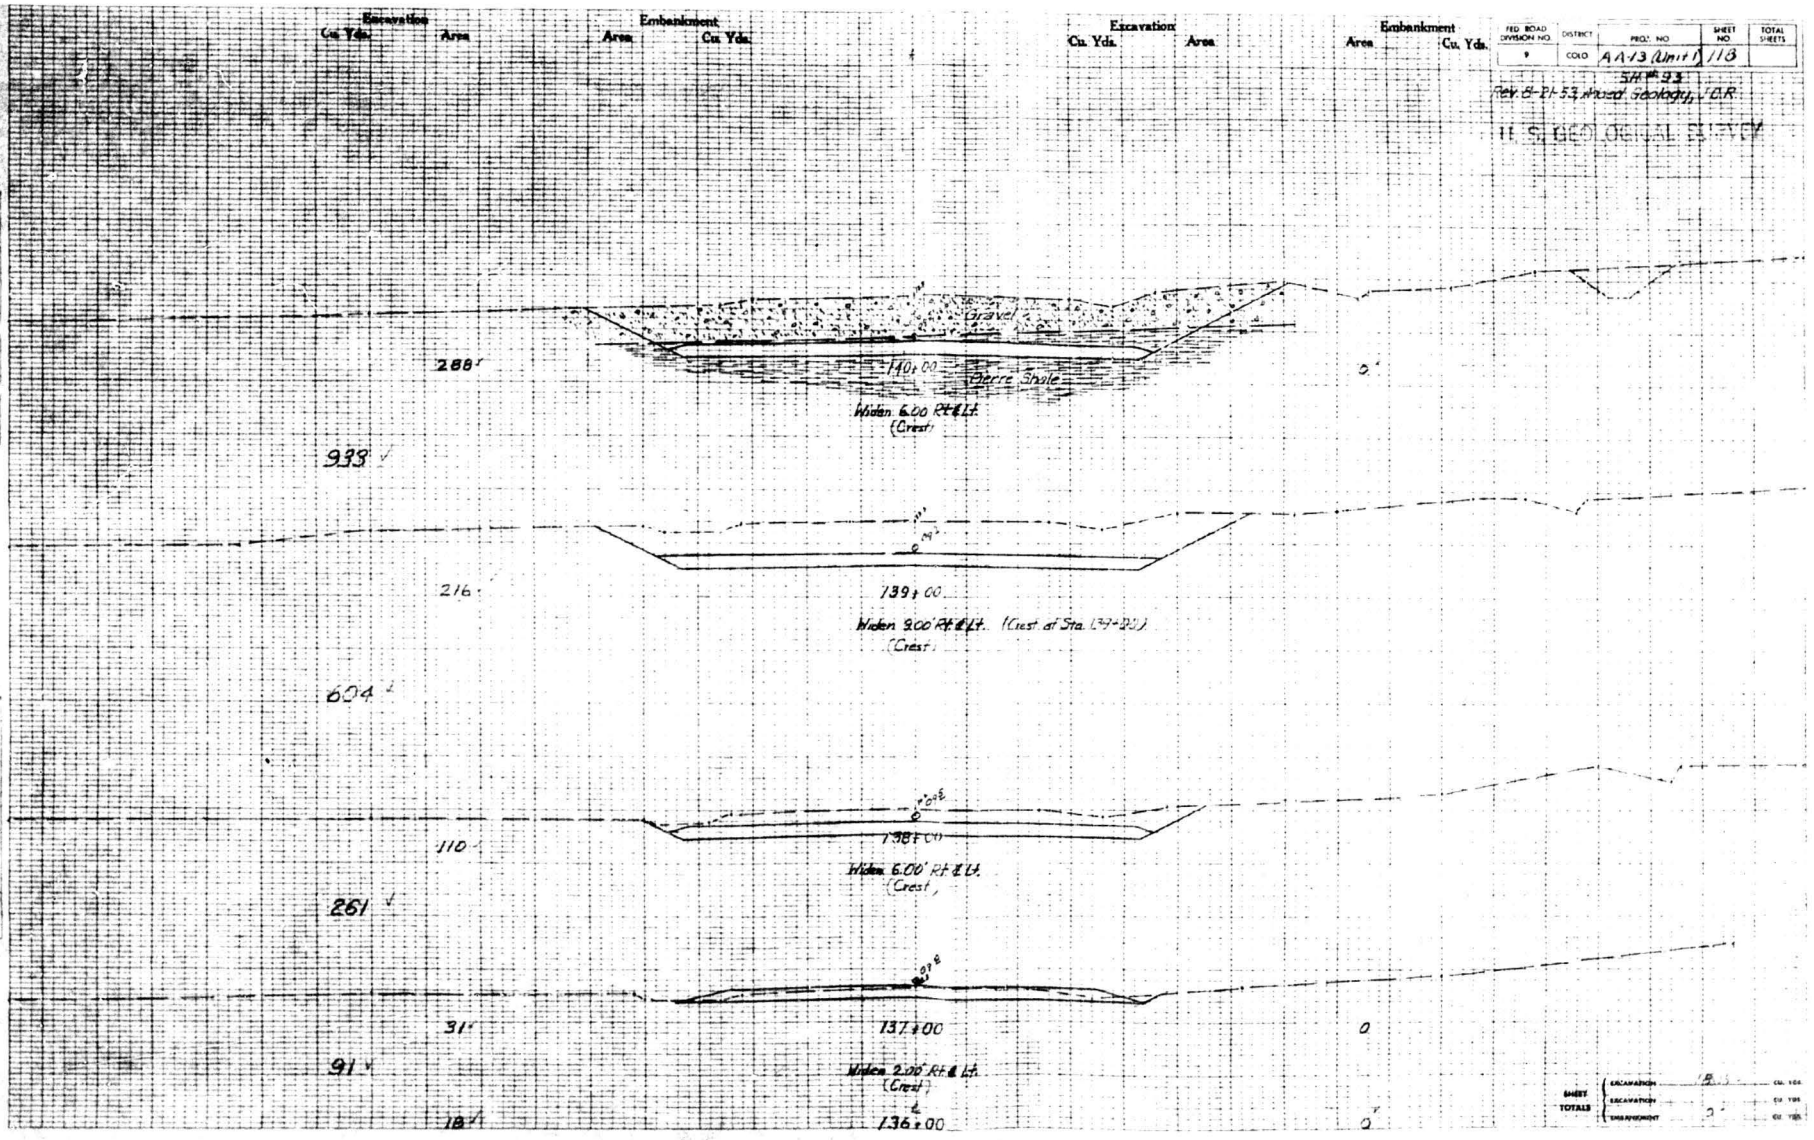

SHEET	EXCAVATION	CU. YDS.
TOTALS	EXCAVATION	CU. YDS.
	EMPAVEMENT	CU. YDS.



Excavation  
Cu. Yds. Area

Embankment  
Area Cu. Yds.


Excavation  
Cu. Yds. Area

Embankment  
Area Cu. Yds.

FED. ROAD DISTRICT	PROJ. NO.	SHEET NO.	TOTAL SHEETS
9	AA-13 (Unit 1)	119	

Rev. 8 of 53, dated Geology, C.R.

U.S. GEOLOGICAL SURVEY

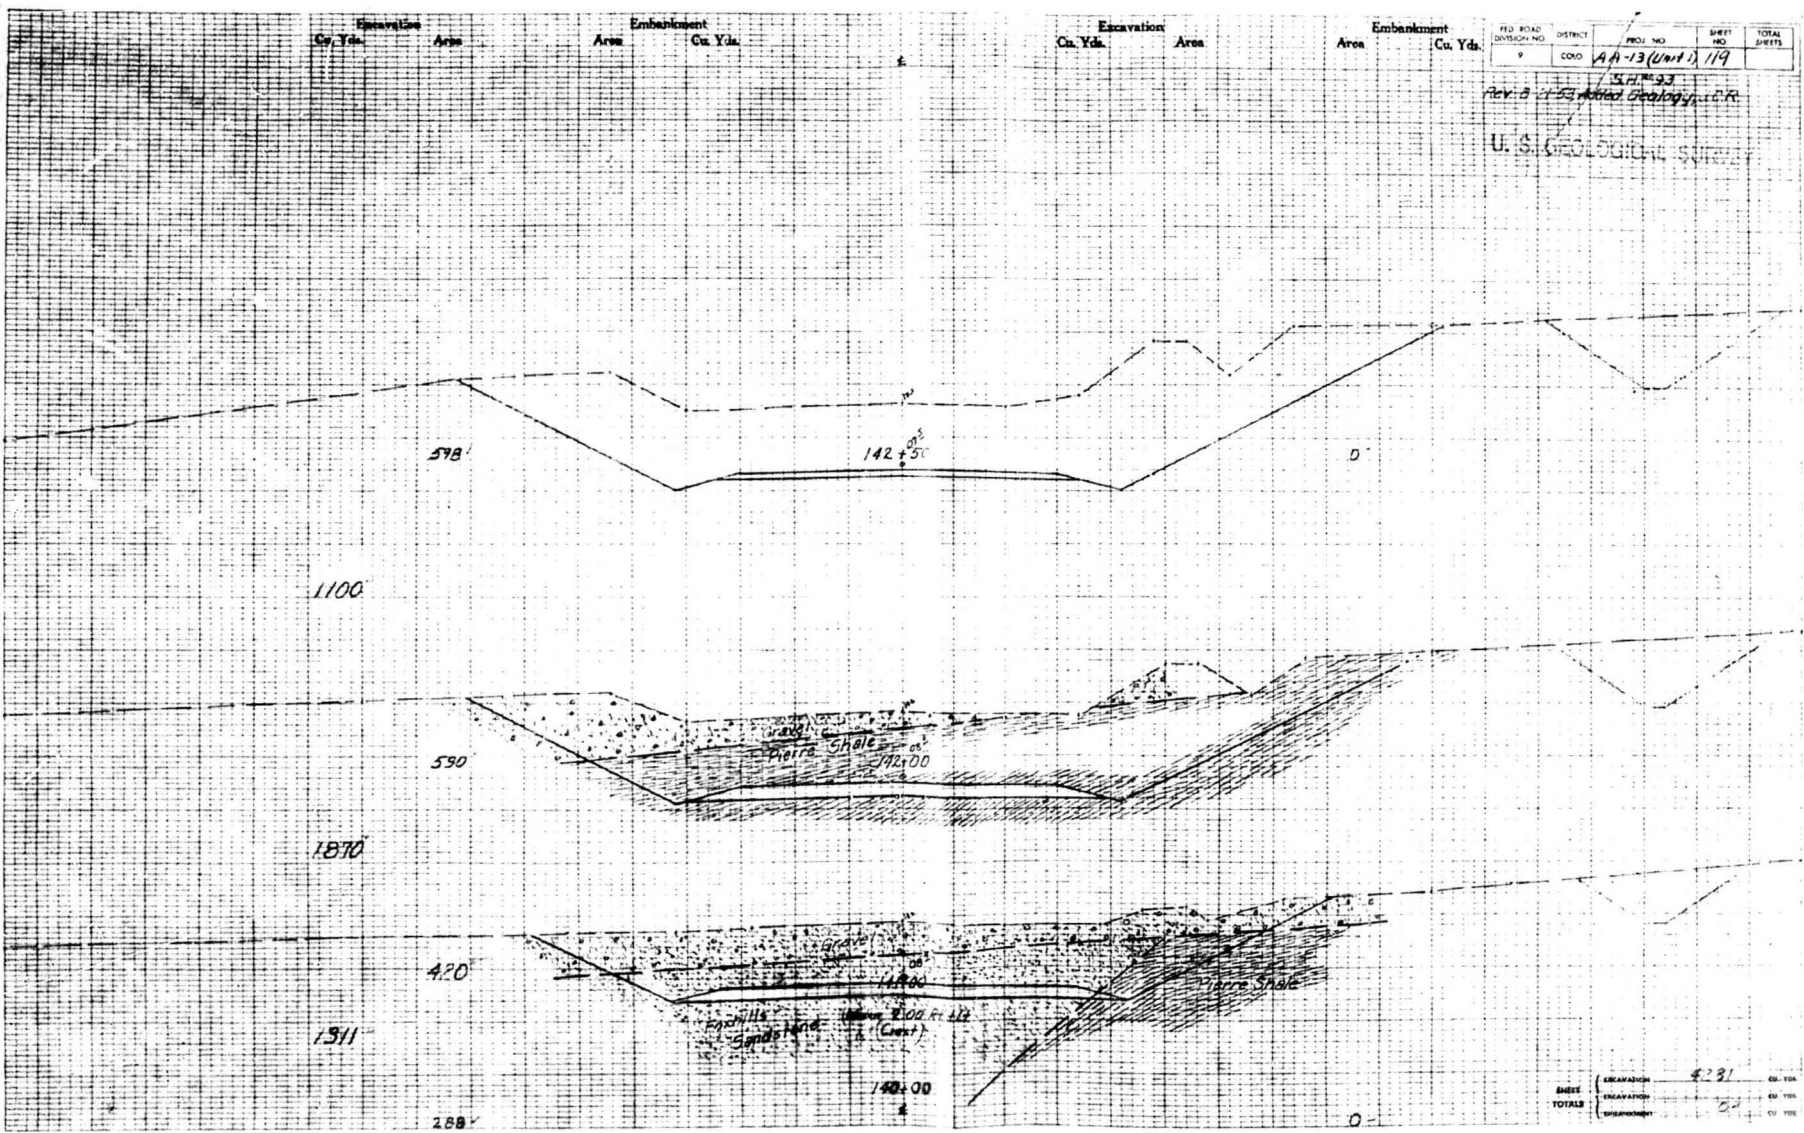

SHEET TOTALS	EXCAVATION	EMBANKMENT	CU. YDS.
	4281	50	

Excavation Area      Embankment Area      Excavation Area      Embankment Area

Cu. Yds.      Cu. Yds.      Cu. Yds.      Cu. Yds.



5-4-93  
REV. 3-21-53, Added Sand Gravel

U.S. GEOLOGICAL SURVEY



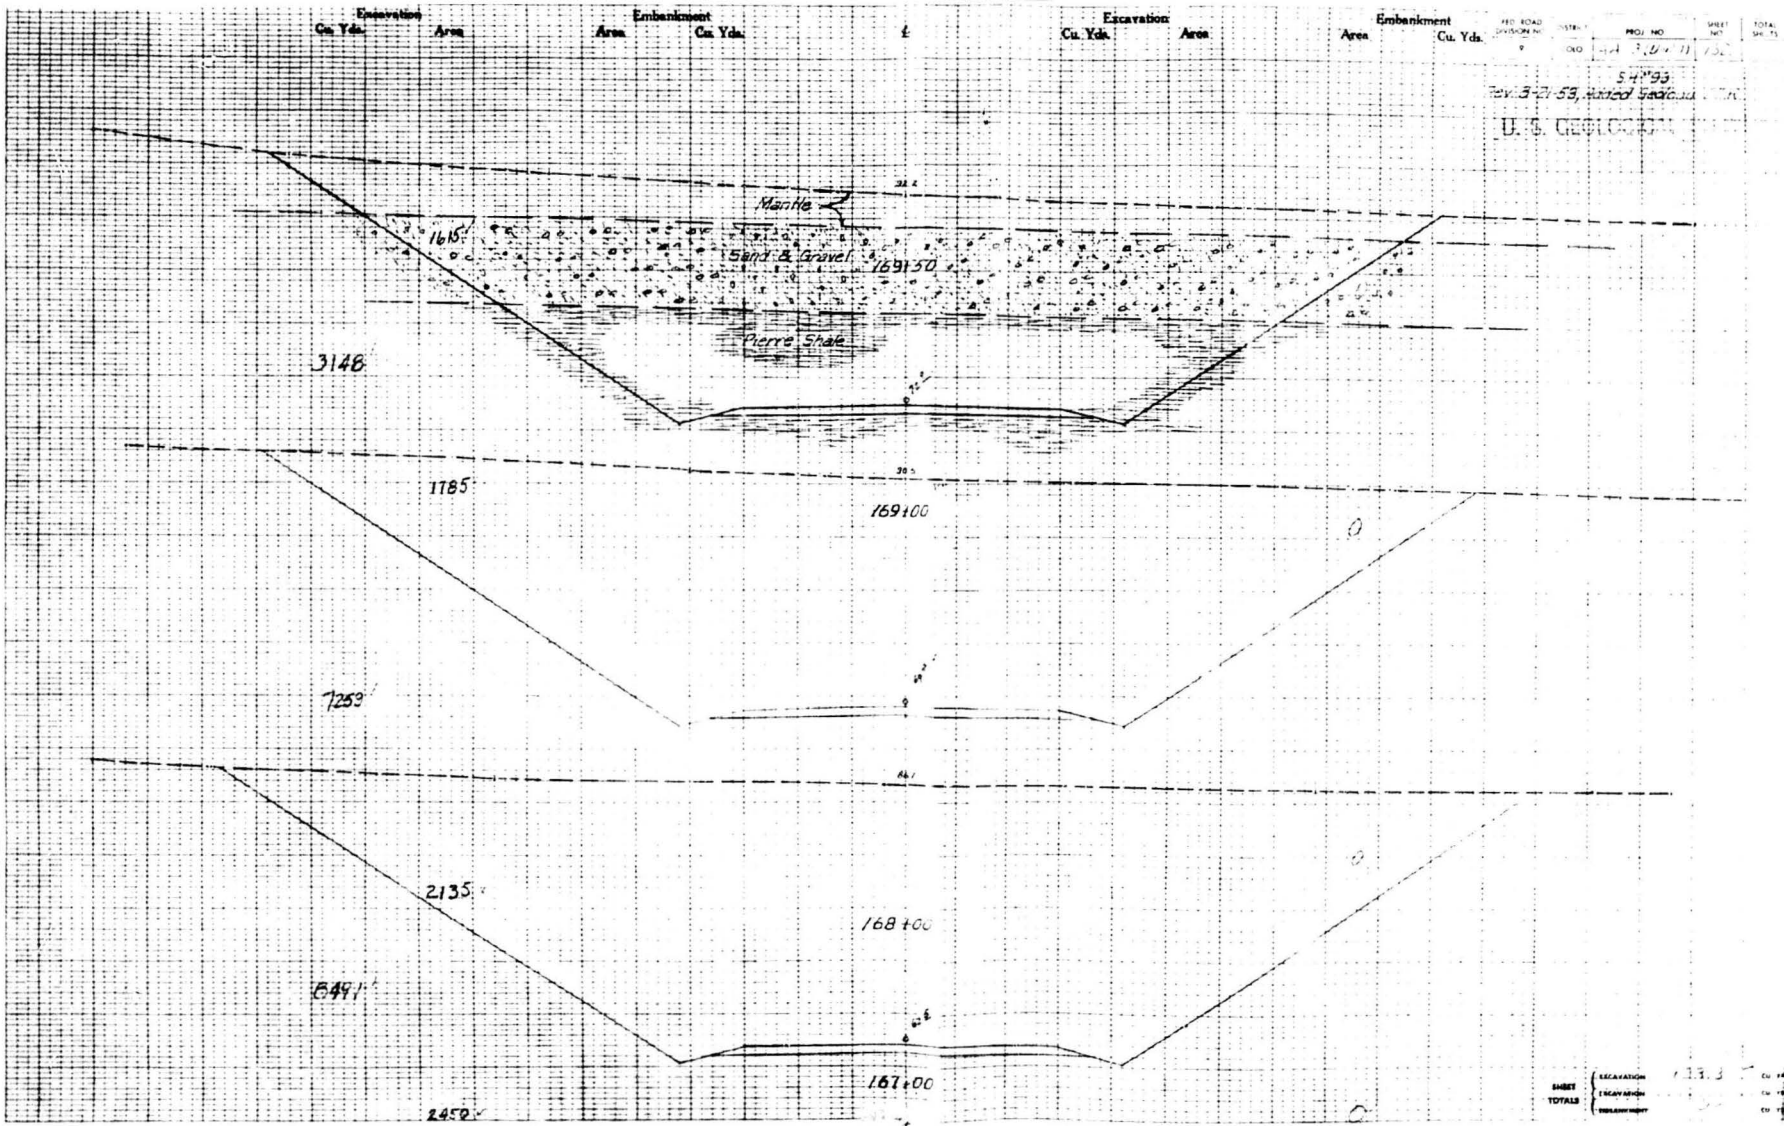


SHEET TOTALS  
EXCAVATION  
EMBANKMENT

Excavation Area Ca. Yds. Area Excavation Area Ca. Yds. Area Excavation Area Ca. Yds.

FED. ROAD DISTRICT	PROJ. NO.	SHEET NO.	TOTAL SHEETS
9	AA-13 (Unit 1)	140	

SP-29.1  
rev. 01-53 added stake 39, 103 R.

U. S. GEOLOGICAL

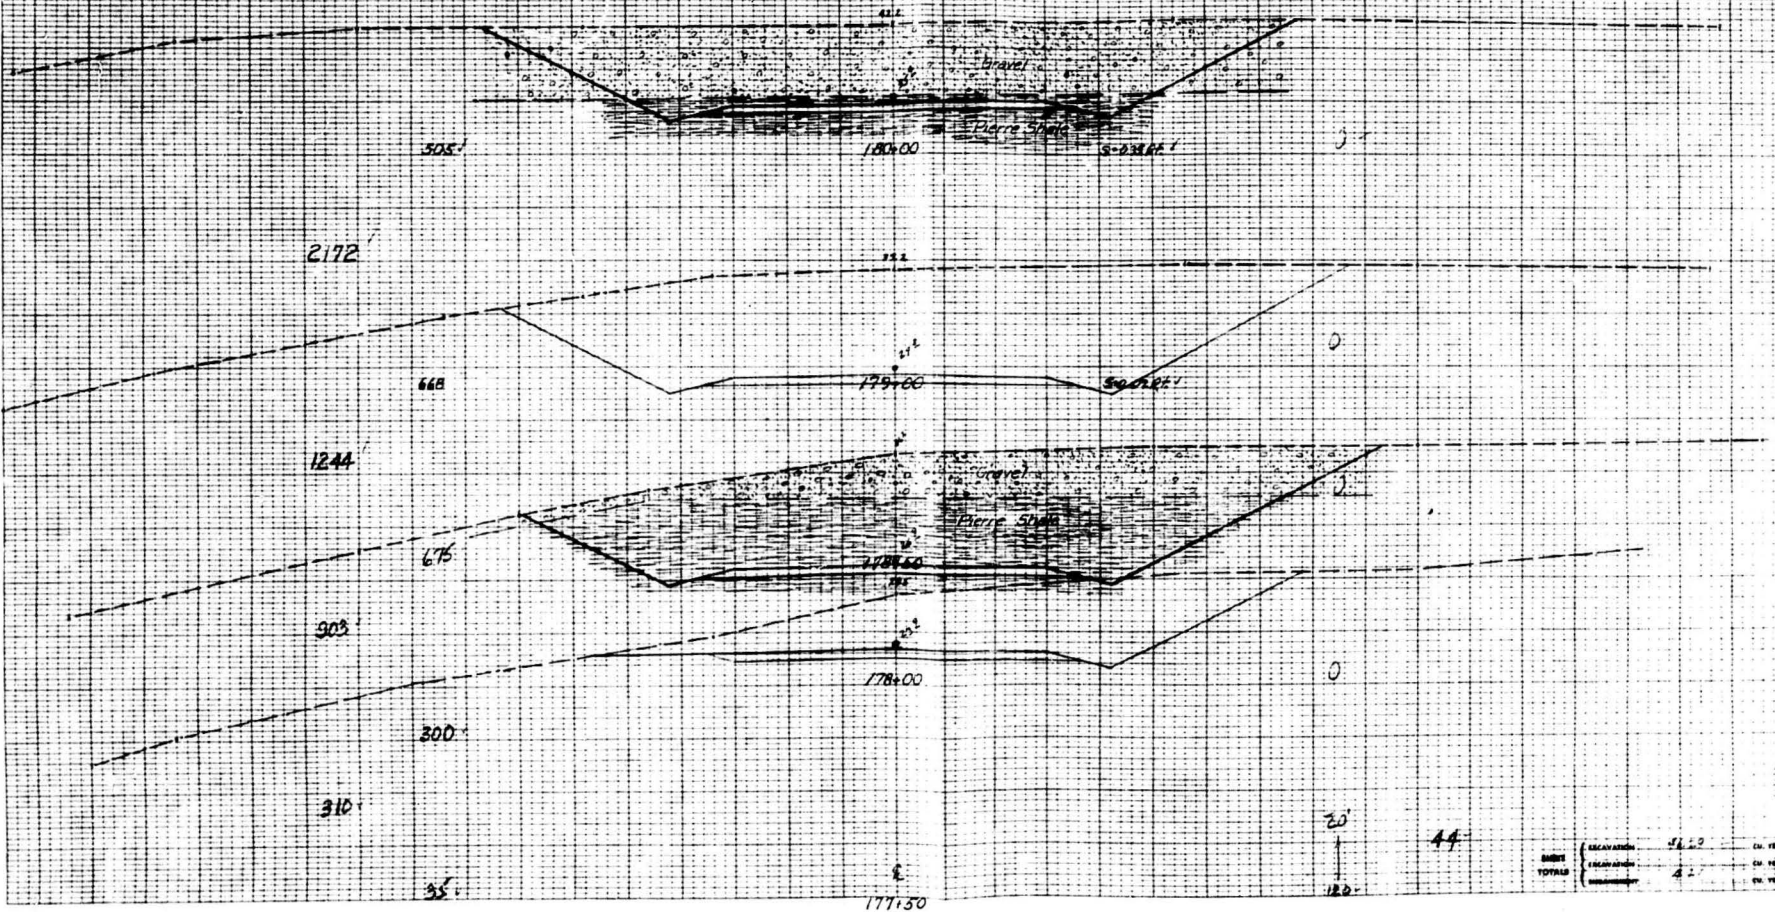


SHEET TOTALS	EXCAVATION	CU. YDS.
	54.2	CU. YDS.
	4.2	CU. YDS.




U.S. GEOLOGICAL SURVEY  

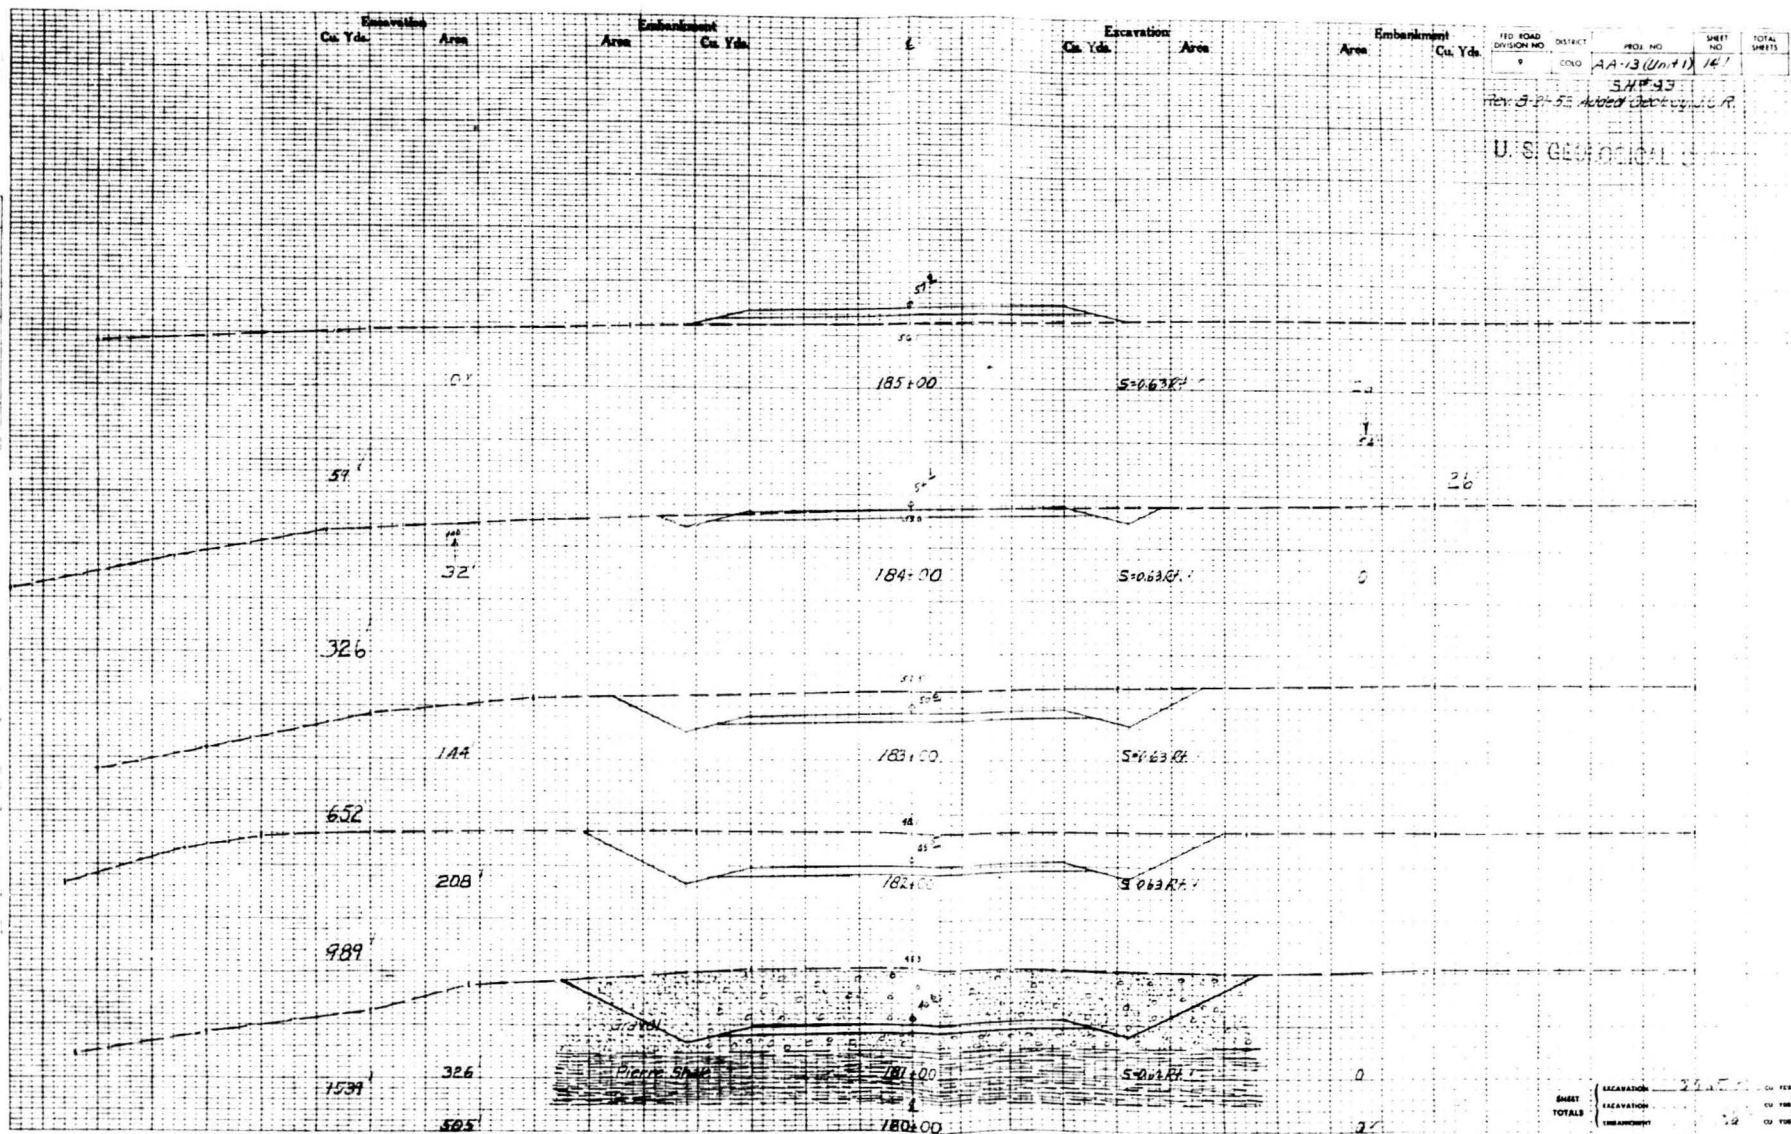

SHEET NO. 14  
 PROJECT NO. AA-13 (Unit 1)  
 DIVISION NO. 9  



Excavation  
Cu. Yds. Area

Embankment  
Cu. Yds. Area

Excavation  
Cu. Yds. Area

Embankment  
Cu. Yds. Area


FED. ROAD DIVISION NO.	DISTRICT	PROJ. NO.	SHEET NO.	TOTAL SHEETS


U. S. GEOLOGICAL SURVEY

1  
2  
1  
2  
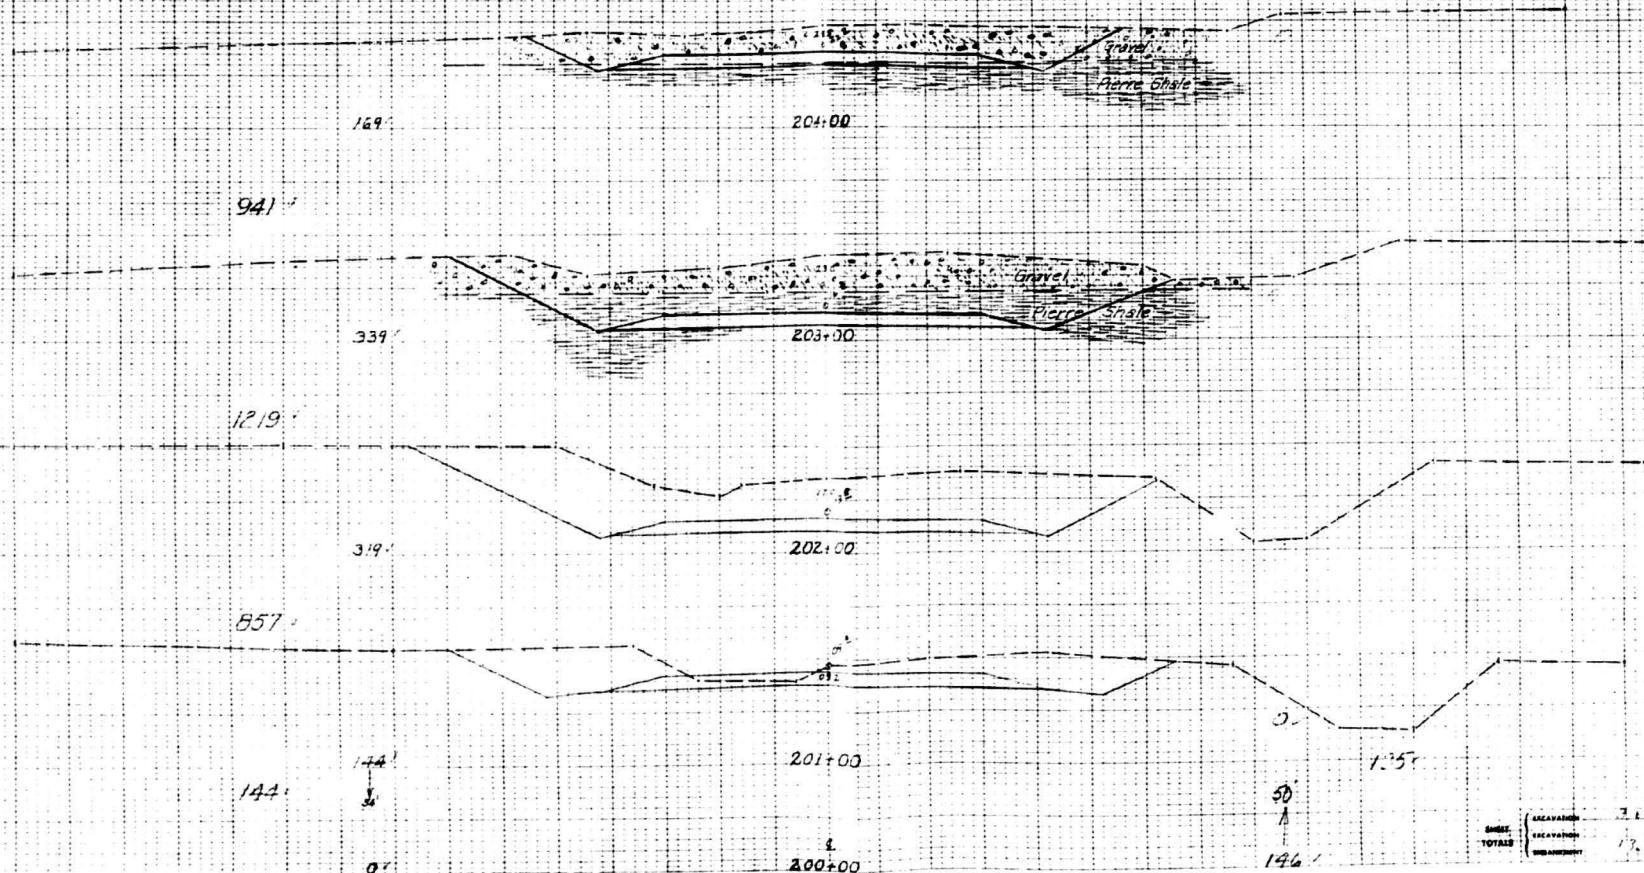

SHEET TOTALS	EXCAVATION	EMBANKMENT	Cu. Yds.	Cu. Yds.
	7.11	13.5		